

SURVEY & REMONUMENTATION

MAR 03 1998

KENT COUNTY REMONUMENTATION

SECTION

LAND CORNER RECORDATION CERTIFICATE
Filing Requirement of Act 74, Mich. P.A. 1970

For corners in
KENT COUNTY

(County)

Located In:

Corner Code #

1. Public Land Survey

T	5N	R	9W	L-4
T		R		
T		R		
T		R		
S		R		
S		R		
S		R		
S		R		

2. Property Controlling in Section

3. Miscellaneous Property in Sec.

4. Lot No. _____, Recorded Plat _____

5. Private Claims _____

STATE OF MICHIGAN
COUNTY OF KENT
RECEIVED FOR RECORD
97 OCT 14 AM 10:30
REG. OF DEEDS
[Signature]
10056

Register of Deeds Stamp & File Number

	A	B	C	D	E	F	G	H	I	J	K	L	M
1													
2	6		5		4		3		2		1		
3													
4	7		8		9		10		11		12		
5													
6	18		17		16		15		14		13		
7													
8	19		20		21		22		23		24		
9													
10	30		29		28		27		26		25		
11													
12	31		32		33		34		35		36		
13													

I, Kirk Breitels, in a field survey on June 13, 1997, do hereby state that under requirements of P.A. 74, Michigan P.A. of 1970, the corner points mentioned in lines 1 and 2 above were in conformance with regulations and rules therefore as required in the current manual of survey instructions of the United States Department of the Interior, Bureau of Land Management or by a decree of a Court of Law and for that the corner points mentioned in lines 3, 4 and 5 above were in conformance with the rules of the Michigan Board of Land Surveyors or by a Decree of a Court of Law; established, re-established, monumented, recovered, found as expressed below:

NOTE: Not more than 2 corners, all in the same town and range, may be recorded on this certificate.


A. Description of original monument and accessories and/or subsequent restoration:
L-4 1830---GLO---Not Set
Williams & Works---No Information
Kent Co. Wits.---No Information

P.A. 345 1990 KENT COUNTY,
PEER APPROVED 7/24/97
CHAIRMAN [Signature]

B. Description of corner evidence found and/or method applied in restoring or reestablishing corner:
L-4 Established intersection of 1/4 lines, found fence N-S to 1' E., on fence line to W., fence to E. is 2' N.
No other information found.

The intersection of 1/4 lines is accepted by me and is generally accepted by professional surveyors as the best available evidence of the position of the corner.

C. Description of monument for corner and accessories established to perpetuate locating the position of the corner:
L-4 Set Standard Kent Co. Monument (Harrison) at the intersection of 1/4 lines
SE corner steel "L" fence post S90°W 12.15'
Nail & KC Remon. tag N. side 22" Beech S70°W 154.65'
Nail & KC Remon. tag W. side 18" Maple N00°E 29.85'
Nail & KC Remon. tag N. side 12" Maple N85°E 31.57'
Nail & KC Remon. tag W. side 6" Cherry S10°E 43.84'

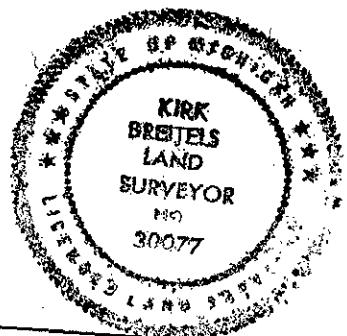

Signed by [Signature]
Surveyor's Michigan License No. 30077

Date 9/24/97