

SURVEY & REMONUMENTATION

APR 27 1995

COMMISSION

Kent County Remonumentation
LAND CORNER RECORDATION CERTIFICATE
 Filing Requirement of Act 74, Mich. P.A. 1970

JAN 31
 STATE OF MICHIGAN
 COUNTY OF KENT
 RECEIVED FOR RECORD
 94 DEC 30 PM 12:06

W. J. Bond
 REG. OF DEEDS

For corners in

Kent County
 (County)

Located In: Bowne Twp.

Corner Code #

1. Public Land Survey	T <u>5N</u> R <u>9W</u>	<u>L-6</u>
	T _____ R _____	_____
	T _____ R _____	_____
	T _____ R _____	_____
2. Property Controlling in Section	S _____ T _____ R _____	_____
	S _____ T _____ R _____	_____
3. Miscellaneous Property in Sec.	S _____ T _____ R _____	_____
	S _____ T _____ R _____	_____

7967

Register of Deeds Stamp & File Number

4. Lot No. _____, Recorded Plat _____
 5. Private Claims _____

	A	B	C	D	E	F	G	H	I	J	K	L	M
2	6	5	4	3	2	1							
3													
4	7	8	9	10	11	12							
5													
6	18	17	16	15	14	13							
7													
8	19	20	21	22	23	24							
9													
10	30	29	28	27	26	25							
11													
12	31	32	33	34	35	36							
13													

I, Robert Jonker, in a field survey on December 24, 19 94, do hereby certify that under requirements of P.A. 74, Michigan P.A. of 1970, the corner points mentioned in lines 1 and 2 above were in conformance with regulations and rules therefore as required in the current manual of survey instructions of the United States Department of the Interior, Bureau of Land Management or by a decree of a Court of Law and/or that the corner points mentioned in lines 3, 4 and 5 above were in conformance with the rules of the Michigan Board of Land Surveyors or by a Decree of a Court of Law; established, re-established, monumented, re-monumented, recovered, found as expressed below:

NOTE: Not more than 4 corners, all in the same town and range, may be recorded on this certificate.

A. Description of original monument and accessories and/or subsequent restoration:

Not set in GLO survey.
 No info, from W & W and other firms research.
 Per C.P.Co. drawing #SF17872, sheet 7, surveyed by E. McCombs, 1976, corner is set @ int. of 1/4 lines, no wit. on map.

P.A. 345 1900 KENT COUNTY
 PEER APPROVED 12/22/94
 CHAIRMAN *Harry Huber*


B. Description of corner evidence found and/or method applied in restoring or reestablishing corner:

Found corner set by C.P.Co. survey.
 Verified position @ intersection of 1/4 lines.

This position not established by original government surveyors. This monument is accepted as the best available evidence of the position of the corner.

C. Description of monument for corner and accessories established to perpetuate locating the position of the corner:

Replaced with 4" standard K.C. Harrison monument.
 K.C. N&T SW side 16" Ash S 50° E 21.0'
 K.C. N&T S. side 12" Ash S 85° E 25.74'
 K.C. N&T W. side 28" Ash N 05° W 28.84'
 K.C. N&T NW side 12" Ash S 20° W 33.67'
 Steel fence post N 85° W 14.0'
 Fence line to South is 14' West
 E-W fence is 2' North
 C/L NE to SW road is 180' E±

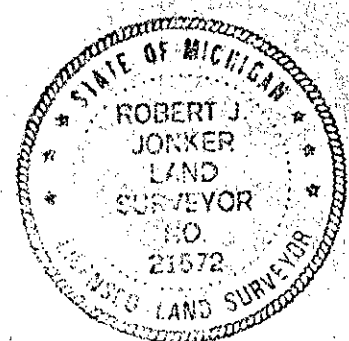

Signed by Robert J. Jonker
 JONKER LAND SURVEYS, P.C. 21572
 Surveyor's Michigan License No. _____

Date December 28, 1994