

**SURVEY & REMONUMENTATION**

APR 27 1995

**COMMISSION**

**Kent County Remonumentation  
LAND CORNER RECORDATION CERTIFICATE  
Filing Requirement of Act 74, Mich. P.A. 1970**

STATE OF MICHIGAN  
COUNTY OF KENT  
RECEIVED FOR RECORD  
94 DEC 30 PM 12:06

*Lucy J. Jones*  
REG. OF DEEDS

7973

Register of Deeds Stamp & File Number

For corners in

Kent Co.  
(County)

Located In: Bowne Twp. Corner Code # L-8

|                                    |                         |            |
|------------------------------------|-------------------------|------------|
| 1. Public Land Survey              | T <u>5N</u> R <u>9W</u> | <u>L-8</u> |
|                                    | T _____ R _____         | _____      |
|                                    | T _____ R _____         | _____      |
|                                    | T _____ R _____         | _____      |
| 2. Property Controlling in Section | S _____ T _____ R _____ | _____      |
|                                    | S _____ T _____ R _____ | _____      |
| 3. Miscellaneous Property in Sec.  | S _____ T _____ R _____ | _____      |
|                                    | S _____ T _____ R _____ | _____      |

4. Lot No. \_\_\_\_\_, Recorded Plat \_\_\_\_\_  
5. Private Claims \_\_\_\_\_

|    | A  | B  | C  | D  | E  | F  | G | H | I | J | K | L | M |
|----|----|----|----|----|----|----|---|---|---|---|---|---|---|
| 2  | 6  | 5  | 4  | 3  | 2  | 1  |   |   |   |   |   |   |   |
| 3  |    |    |    |    |    |    |   |   |   |   |   |   |   |
| 4  | 7  | 8  | 9  | 10 | 11 | 12 |   |   |   |   |   |   |   |
| 5  |    |    |    |    |    |    |   |   |   |   |   |   |   |
| 6  | 18 | 17 | 16 | 15 | 14 | 13 |   |   |   |   |   |   |   |
| 7  |    |    |    |    |    |    |   |   |   |   |   |   |   |
| 8  | 19 | 20 | 21 | 22 | 23 | 24 |   |   |   |   |   |   |   |
| 9  |    |    |    |    |    |    |   |   |   |   |   |   |   |
| 10 | 30 | 29 | 28 | 27 | 26 | 25 |   |   |   |   |   |   |   |
| 11 |    |    |    |    |    |    |   |   |   |   |   |   |   |
| 12 | 31 | 32 | 33 | 34 | 35 | 36 |   |   |   |   |   |   |   |
| 13 |    |    |    |    |    |    |   |   |   |   |   |   |   |

I, Robert Jonker, in a field survey on December 15, 19 94, do hereby certify that under requirements of P.A. 74, Michigan P.A. of 1970, the corner points mentioned in lines 1 and 2 above were in conformance with regulations and rules therefore as required in the current manual of survey instructions of the United States Department of the Interior, Bureau of Land Management or by a decree of a Court of Law and/or that the corner points mentioned in lines 3, 4 and 5 above were in conformance with the rules of the Michigan Board of Land Surveyors or by a Decree of a Court of Law; established, re-established, monumented, re-monumented, recovered, found as expressed below:

**NOTE: Not more than 4 corners, all in the same town and range, may be recorded on this certificate.**

**A. Description of original monument and accessories and/or subsequent restoration:**

Not set in GLO survey. No info. from W&W and other firms research. Old County wit. map, 1953, Iron

LCRC #3761, 1984, Doug Bonnema, P.S. #12579, Found 1/2" iron @ int. of 1/4 lines Took witnesses & checks OK to stumps on wit. map.

NW corner garage found SE 95.36'  
NW corner garage found ESE 85.37'  
N&T N. side fence post W 30.11'  
Iron is on C/L N-S, & tree row & fence line E & W

P.A. 345 1990 KENT COUNTY  
PEER APPROVED 12/15/94  
CHAIRMAN *Harry Huber*

**B. Description of corner evidence found and/or method applied in restoring or reestablishing corner:**


Found 1/2" iron per LCRC #3761 inside of 1 1/4" pipe over 2-1" pipes down 24" Verified position at intersection of 1/4 lines

This position not established by original government surveyors. This monument is accepted as the best available evidence of the position of the corner.

**C. Description of monument for corner and accessories established to perpetuate locating the position of the corner:**

Replaced with 4" standard K.C. Harrison monument.

K.C. N&T N. side P.pole N 90° E 62.05'  
K.C. N&T S. side R.R. fence post N 60° W 39.86'  
NW corner house fnd. S 40° E 95.35'  
NW corner garage fnd. S 80° E 85.38'  
SW corner garage fr. cor. S 55° E 97.09'  
Extension of fence line to West is 0.5' N  
C/L N-S road is 1'±W

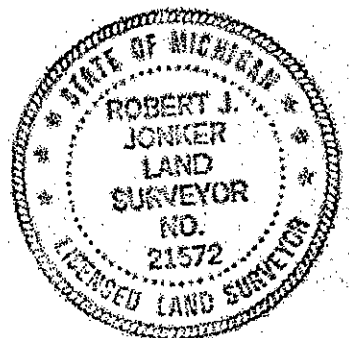

Signed by Robert J. Jonker  
JONKER LAND SURVEYS, P.C.  
Surveyor's Michigan License No. 21572

Date December 28, 1994