SURVEY & REMONUMENTATION

MAR 0 3 1998

KENT COUNTY REMONUMENTATION

2/2

# LAND CORNER RECORDATION CERTIFICATE
**Filing Requirement of Act 74, Mich. P.A. 1970**

SECTION

For corners in KENT COUNTY (County)

| | Located In: | Corner Code # |
|---|---|---|
| 1. Public Land Survey | T5N R9W | L-11 |
| | T___ R___ | |
| | T___ R___ | |
| | T___ R___ | |
| 2. Property Controlling | S___ T___ R___ | |
| in Section | S___ T___ R___ | |
| 3. Miscellaneous | S___ T___ R___ | |
| Property in Sec. | S___ T___ R___ | |

STATE OF MICHIGAN COUNTY OF KENT RECEIVED FOR RECORD 97 APR 29 AM 8:20 REG. OF DEEDS

9782

Register of Deeds Stamp & File Number

4. Lot No. _____, Recorded Plat _____
5. Private Claims _____

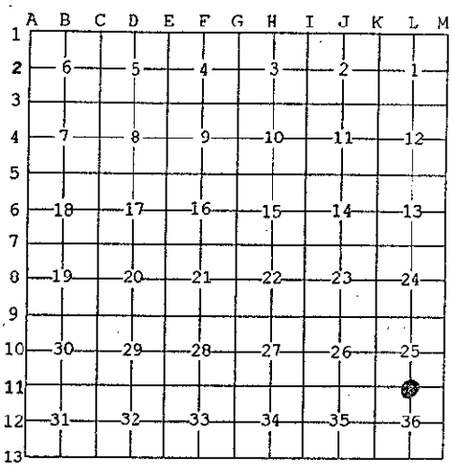


I, Kirk Breitels, in a field survey on Feb. 5, 19 97 do hereby state that under requirements of P.A. 74, Michigan P.A. of 1970, the corner points mentioned in lines 1 and 2 above were in conformance with regulations and rules therefore as required in the current manual of survey instructions of the United States Department of the Interior, Bureau of Land Management or by a decree of a Court of Law and /or that the corner points mentioned in lines 3, 4 and 5 above were in conformance with the rules of the Michigan Board of Land Surveyors or by a Decree of a Court of Law; established, re-established, monumented, recovered, found as expressed below:

NOTE: Not more than 2 corners, all in the same town and range, may be recorded on this certificate.

A. Description of original monument and accessories and/or subsequent restoration:

| | | | | |
|---|---|---|---|---|
| L-11 | 1830 | GLO | Mullett | Set Post |
| | 1961 | Kent Co. Wit. | | Monument |
| | 1977 | LCRC #1132 | VanKooten | Solid Iron |
| | 1977 | LCRC #1234 | Byl | Large Nail in Mon. Box |
| | 1982 | LCRC #2854 | Jonker | Set Kent County Monument in Mon. Box |
| | 1994 | LCRC #6995 | Byl | Kent County Monument in Mon. Box |

The position of this corner was previously approved by the Kent County Remonumentation Peer Group, monumented by Robert J. Jonker on 5/12/82 and was recorded per LCRC #2854.

B. Description of corner evidence found and/or method applied in restoring or reestablishing corner:

L-11 Found standard Kent Co. Mon. (Harrison) per witnesses from above LCRC as set by Robert J. Jonker in place of the Capped Rerod over a Solid bar in a Conc. Mon. he found inside a Mon. box. Rerod & Solid bar check with Kent Co. Wit. and LCRC's #1132 & #1234

| LCRC #2854 | | | LCRC #6995 | | |
|---|---|---|---|---|---|
| Remon. tag 30" Walnut | N70°E | 59.39' | Nail & tag 33" Walnut | N70°E | 59.38' |
| Remon. tag 20" Walnut | N15°E | 126.00' | Nail & tag 24" Walnut | N15°E | 126.05' |
| Remon. tag P. Pole | S55°W | 57.66' | Nail & tag P. Pole | S55°W | 57.66' |
| Remon. tag 9" Walnut | S15°W | 123.82' | Nail & tag 12" Walnut | S15°W | 124.05' |
| "X" on S. end culv. | S55°E | 56.80' | "X" on S. end culv. | S55°E | 56.86' |

The selected location is accepted by me and is generally accepted by professional surveyors as the best available evidence of the position of the original corner.

C. Description of monument for corner and accessories established to perpetuate locating the position of the corner:

L-11 Standard Kent County Monument in Mon. Box

| | | |
|---|---|---|
| Nail & KC Remon. tag S. side 33" Walnut | N70°E | 59.38' |
| Nail & KC Remon. tag W. side 24" Walnut | N15°E | 126.05' |
| Nail & KC Remon. tag N. side P. Pole | S55°W | 57.66' |
| Nail & KC Remon. tag W. side 15" Walnut | S15°W | 124.05' |
| Chiseled "X" on S. end of culvert On C/L "X" pavement | S55°E | 56.86' |

STATE OF MICHIGAN KIRK BREITELS LAND SURVEYOR MO 30077 LICENSED LAND SURVEYOR

Signed by Kirk Breitels

Date 3/27/97

Surveyor's Michigan License No. 30077

P.A. 345 1990 KENT COUNTY
PEER APPROVED 3/27/97
CHAIRMAN Harry Huber

FORM APPROVED BY MICHIGAN STATE BOARD OF PROFESSIONAL SURVEYORS, JAN. 28, 1971
REVISED MAY 14, 1975
REVISED JAN., 1983
REVISED OCT., 1995