

**SURVEY & REMONUMENTATION**

**KENT COUNTY REMONUMENTATION**

**LAND CORNER RECORDATION CERTIFICATE**  
Filing Requirement of Act 74, Mich. P.A. 1970

For corners in **KENT COUNTY**

**MAR 03 1998**

STATE OF MICHIGAN  
COUNTY OF KENT  
RECEIVED FOR RECORD  
97 OCT 14 AM 10:03  
REG. OF DEEDS  
*Lucy Bond*

1. Public Land Survey	Located In: T 5N R 9W	Corner Code # L-12
	T R	
	T R	
	T R	
2. Property Controlling in Section	S T R	
	S T R	
3. Miscellaneous Property in Sec.	S T R	
	S T R	

**10034**

Register of Deeds Stamp & File Number

4. Lot No. \_\_\_\_\_, Recorded Plat \_\_\_\_\_  
5. Private Claims \_\_\_\_\_

I, Kirk Breitels, in a field survey on June 13, 1997 do hereby state that under requirements of P.A. 74, Michigan P.A. of 1970, the corner points mentioned in lines 1 and 2 above were in conformance with regulations and rules therefore as required in the current manual of survey instructions of the United States Department of the Interior, Bureau of Land Management or by a decree of a Court of Law and for that the corner points mentioned in lines 3, 4 and 5 above were in conformance with the rules of the Michigan Board of Land Surveyors or by a Decree of a Court of Law; established, re-established, monumented, recovered, found as expressed below:

NOTE: Not more than 2 corners, all in the same town and range, may be recorded on this certificate.

1	A	B	C	D	E	F	G	H	I	J	K	L	M
2		6		5		4		3		2		1	
3													
4		7		8		9		10		11		12	
5													
6		18		17		16		15		14		13	
7													
8		19		20		21		22		23		24	
9													
10		30		29		28		27		26		25	
11													
12		31		32		33		34		35		36	
13													

**A. Description of original monument and accessories and/or subsequent restoration:**

- L-12 1830---GLO---Not Set
- Williams & Works---No information
- 1950---Kent Co. Wits.---Monument
- Cor. Fe. West 30.4' MBT ENE 28.70'
- 6" Cherry ENE 36.5' 12" Box Elder SSW 81.85'
- 1978---LCRC #1131---VanKooten---Iron in Mon. Box
- Fence Post W 31.41' SW cor. steel fe. post E 33.47'
- Wood fence post NW 64.96'

**B. Description of corner evidence found and/or method applied in restoring or reestablishing corner:**


- L-12 Found Kent Co. Monument in Monument Box per 1 remaining witness:
- SW cor. steel fence post East 33.61' (leaning E'ly)
- Fence to East is 2'± North

Kent Co. Monument is 0.3' E. & 1.4' S. from intersection of 1/4 lines and agrees with measurments of others.

The Kent Co. Monument in Monument Box is accepted by me and is generally accepted by professional surveyors as the best available evidence of the position of the corner.

**C. Description of monument for corner and accessories established to perpetuate locating the position of the corner:**

- L-12 Standard Kent Co. Monument (Harrison) in Monument Box (wits. by EDM)
- Nail & KC Remon. tag S. side P. Pole S75°E 67.72'
- Concrete Monument - GPS point 05-09-36 N40°E 44.77'
- Nail & KC Remon. tag top of fence post S65°W 32.70'
- Nail & KC Remon. tag W. side P. Pole S10°E 309.63'
- On C/L N-S asphalt road
- Fence to East is North 2'±

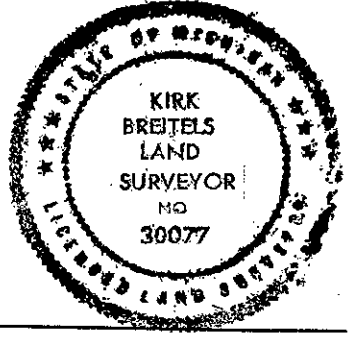

Signed by *Kirk Breitels*  
Surveyor's Michigan License No. 30077

Date 8/28/97

P.A. 345 1990 KENT COUNTY  
PEER APPROVED 7/24/97  
CHAIRMAN *Garry Hubert*