

**SURVEY & REMONUMENTATION**

**KENT COUNTY REMONUMENTATION**

MAR 03 1998

**LAND CORNER RECORDATION CERTIFICATE**  
Filing Requirement of Act 74, Mich. P.A. 1970

REG. OF DEEDS

*Lucy Bond*

97 APR 29 AM 8:20

STATE OF MICHIGAN  
COUNTY OF KENT  
RECEIVED FOR RECORD

For corners in **SECTION**  
**KENT COUNTY**

Located in:

Corner Code #

1. Public Land Survey

T 5N R 9W M-2  
T R  
T R  
T R

2. Property Controlling in Section

S T R  
S T R  
S T R

3. Miscellaneous Property in Sec.

S T R  
S T R

4. Lot No. \_\_\_\_\_, Recorded Plat \_\_\_\_\_  
5. Private Claims \_\_\_\_\_

9784

Register of Deeds Stamp & File Number

	A	B	C	D	E	F	G	H	I	J	K	L	M
1													
2	6		5		4		3		2				1
3													
4	7		8		9		10		11				12
5													
6	18		17		16		15		14				13
7													
8	19		20		21		22		23				24
9													
10	30		29		28		27		26				25
11													
12	31		32		33		34		35				36
13													

I, Kirk Breitels, in a field survey on Jan. 29, 1997 do hereby state that under requirements of P.A. 74, Michigan P.A. of 1970, the corner points mentioned in lines 1 and 2 above were in conformance with regulations and rules therefore as required in the current manual of survey instructions of the United States Department of the Interior, Bureau of Land Management or by a decree of a Court of Law and/or that the corner points mentioned in lines 3, 4 and 5 above were in conformance with the rules of the Michigan Board of Land Surveyors or by a Decree of a Court of Law; established, re-established, monumented, recovered, found as expressed below:

NOTE: Not more than 2 corners, all in the same town and range, may be recorded on this certificate.

A. Description of original monument and accessories and/or subsequent restoration:

M-2	1830	GLO	Mullett	Set Post
	1965	Kent Co. Wit.		"T" Iron
	1981	LCRC #1630	Byl	Iron Pipe
	1982	LCRC #2856	Jonker	Set Kent County Monument
	1994	LCRC #6996	Byl	Kent County Monument

The position of this corner was previously approved by the Kent County Remonumentation Peer Group, monumented by Robert J. Jonker on 5/13/82 and was recorded per LCRC #2856


B. Description of corner evidence found and/or method applied in restoring or reestablishing corner:

M-2 Found standard Kent Co. Mon. (Harrison) per witnesses from above LCRC as set by Robert J. Jonker in place of the Iron Pipe with "T" Iron inside over a 1 1/2" Iron he found. All Irons check with Kent Co. Wit. and LCRC #1630.  
 LCRC #2856 Face R/W marker S10°E 23.83' LCRC #6996 Face RR R/W marker S10°E 23.83'  
 Remon. tag RR tie fc. post S30°W 32.5' SW corner conc. hdwall: N65°W 71.29'  
 Remon. tag T. Pole S30°E 41.62' Boat spike at approx. C/L "X" S90°W 31.28'  
 Remon. tag T. Pole N30°E 41.34' Nail & tag 48" Box Elder S50°W 36.67'  
 SW cor. conc. hdwall N65°W 71.24' Nail & tag P. Pole S30°E 62.61'  
 Boat Spike at C/L "X" West 31.28' Nail & tag 24" Box Elder N70°E 60.14'

The selected location is accepted by me and is generally accepted by professional surveyors as the best available evidence of the position of the original corner.

C. Description of monument for corner and accessories established to perpetuate locating the position of the corner:

M-2	Standard Kent County Monument	N65°W	71.29'
	SW corner concrete headwall	S90°W	31.28'
	Boat Spike at approx. C/L intersection	S10°E	23.83'
	Face (at base) concrete marker	S50°W	36.67'
	Nail & KC Remon. tag NW side 48" Box Elder	S30°E	62.61'
	Nail & KC Remon. tag E. side Power Pole	N70°E	60.14'
	Nail & KC Remon. tag N. side 24" Box Elder		
	C/L E-W pavement is 1'± South		

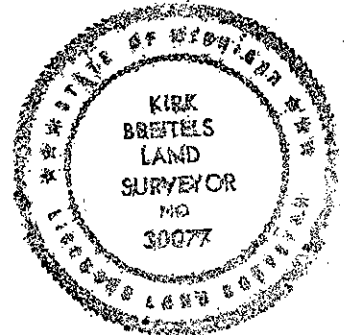

Signed by

*Kirk Breitels*

Date

3/27/97

Surveyor's Michigan License No. 30077

P.A. 345 1990 KENT COUNTY

PEER APPROVED 3/27/97

CHAIRMAN *Harry Kubell*