

**SURVEY & REMONUMENTATION**

MAR 03 1998

KENT COUNTY REMONUMENTATION

**LAND CORNER RECORDATION CERTIFICATE**  
Filing Requirement of Act 74, Mich. P.A. 1970

REG. OF DEEDS

*Lucy Bond*

97 APR 29 AM 8:20

STATE OF MICHIGAN  
COUNTY OF KENT  
RECEIVED FOR RECORD

For corners in **SECTION**  
**KENT COUNTY**

Located In: Corner Code #

1. Public Land Survey	T 5N R 9W	M-4
	T R	
	T R	
	T R	
2. Property Controlling in Section	S T R	
	S T R	
3. Miscellaneous Property in Sec.	S T R	
	S T R	

9786

Register of Deeds Stamp & File Number

4. Lot No. \_\_\_\_\_, Recorded Plat \_\_\_\_\_  
5. Private Claims \_\_\_\_\_

	A	B	C	D	E	F	G	H	I	J	K	L	M
1													
2	6	5	4	3	2	1							
3													
4	7	8	9	10	11	12							
5													
6	18	17	16	15	14	13							
7													
8	19	20	21	22	23	24							
9													
10	30	29	28	27	26	25							
11													
12	31	32	33	34	35	36							
13													

I, Kirk Breitels, in a field survey on Feb. 27, 1997 do hereby state that under requirements of P.A. 74, Michigan P.A. of 1970, the corner points mentioned in lines 1 and 2 above were in conformance with regulations and rules therefore as required in the current manual of survey instructions of the United States Department of the Interior, Bureau of Land Management or by a decree of a Court of Law and /or that the corner points mentioned in lines 3, 4 and 5 above were in conformance with the rules of the Michigan Board of Land Surveyors or by a Decree of a Court of Law; established, re-established, monumented, recovered, found as expressed below:

NOTE: Not more than 2 corners, all in the same town and range, may be recorded on this certificate.

A. Description of original monument and accessories and/or subsequent restoration:

M-4	1830	GLO	Mullett	Set Post
	1949	Kent Co. Wit.		3/4" Iron
	1973	LCRC #3260	Hay	3/4" Iron
	1983	LCRC #3599	Kolehouse	Set Kent County Monument
	1994	LCRC #6998	Byl	Kent County Monument

The position of this corner was previously approved by the Kent County Remonumentation Peer Group, monumented by Randy J. Kolehouse on 11/9/83 and was recorded per LCRC #3599

B. Description of corner evidence found and/or method applied in restoring or reestablishing corner:


M-4 Found standard Kent Co. Mon. (Harrison) per witnesses from above LCRC as set by Randy J. Kolehouse in place of the 1/4" Sq. Iron in top of a 3/4" Iron he found. Both Irons check with Kent Co. Wit. and LCRC #3260

<u>LCRC #3599</u>		<u>LCRC #6998</u>	
Nail & tag P. Pole	East 64.6'	Nail & tag P. Pole	N90°E 64.96'
Nail & tag 12" Elm	S20°E 73.05'	Nail & tag fence post	S40°W 35.24'
Nail & tag 8" Elm	S45°E 51.82'	Nail & tag 10" Elm	S20°E 77.81'
Nail & tag fence post	S40°W 33.8'		

The selected location is accepted by me and is generally accepted by professional surveyors as the best available evidence of the position of the original corner.

C. Description of monument for corner and accessories established to perpetuate locating the position of the corner:

M-4	Standard Kent County Monument
Nail & KC Remon. tag S. side	Power Pole N90°E 64.89'
Nail & KC Remon. tag SE side	fence post S40°W 35.21'
Nail & KC Remon. tag W. side	12" Elm S20°E 77.86'
Nail & KC Remon. tag W. side	Power Pole N10°E 454.08'
Nail & KC Remon. tag E. side	fence post N05°W 303.93'
In C/L N-S gravel road	

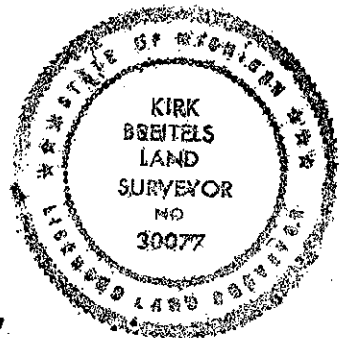

Signed by *Kirk Breitels*  
Surveyor's Michigan License No. 30077

Date 3/27/97

P.A. 345 1990 KENT COUNTY  
PEER APPROVED 3/27/97  
CHAIRMAN *Hamp Hubert*