

SURVEY & REMONUMENTATION

MAR 03 1998

KENT COUNTY REMONUMENTATION

LAND CORNER RECORDATION CERTIFICATE
Filing Requirement of Act 74, Mich. P.A. 1970

SECTION
For corners in
KENT COUNTY
(County)

Located In: Corner Code #

- | | | |
|------------------------------------|-----------|-----|
| 1. Public Land Survey | T 5N R 9W | M-6 |
| | T R | |
| | T R | |
| | T R | |
| 2. Property Controlling in Section | S T R | |
| | S T R | |
| 3. Miscellaneous Property in Sec. | S T R | |
| | S T R | |

STATE OF MICHIGAN
 COUNTY OF KENT
 RECEIVED FOR RECORD
 97 APR 29 AM 8:20
 REG. OF DEEDS
Lucy St. Grand

9788

Register of Deeds Stamp & File Number

4. Lot No. _____, Recorded Plat _____
 5. Private Claims _____

I, Kirk Breitels, in a field survey on Feb. 10, 1997 do hereby state that under requirements of P.A. 74, Michigan P.A. of 1970, the corner points mentioned in lines 1 and 2 above were in conformance with regulations and rules therefore as required in the current manual of survey instructions of the United States Department of the Interior, Bureau of Land Management or by a decree of a Court of Law and/or that the corner points mentioned in lines 3, 4 and 5 above were in conformance with the rules of the Michigan Board of Land Surveyors or by a Decree of a Court of Law, established, re-established, monumented, recovered, found as expressed below:

NOTE: Not more than 2 corners, all in the same town and range, may be recorded on this certificate.

	A	B	C	D	E	F	G	H	I	J	K	L	M
1													
2		6		5		4		3		2		1	
3													
4		7		8		9		10		11		12	
5													
6		18		17		16		15		14		13	
7													
8		19		20		21		22		23		24	
9													
10		30		29		28		27		26		25	
11													
12		31		32		33		34		35		36	
13													

A. Description of original monument and accessories and/or subsequent restoration:

M-6	1830	GLO	Mullett	Set Post
		Williams & Works		Stone, 9' West of C/L RR
	1976	Consumers Power		Set Rebar from RR information
	1985	LCRC #6655	Jonker	Set Kent County Monument

The position of this corner was previously approved by the Kent County Remonumentation Peer Group, monumented by Robert J. Jonker on 3/6/85 and was recorded per LCRC #6655

B. Description of corner evidence found and/or method applied in restoring or reestablishing corner:

M-6 Found standard Kent Co. Mon. (Harrison) per witnesses from above LCRC as set by Robert J. Jonker in place of the Capped Rerod (CP Co.) he found. Said Rerod checks with Consumers Power information.
 LCRC #6655

- Nail & KC Remon. tag W. side 6" Hickory S25°E 49.14'
- Nail & KC Remon. tag SE side 9" Maple S50°W 26.95'
- Nail & KC Remon. tag NE side 10" Hickory N30°W 40.65'
- Nail & KC Remon. tag NW side 8" Ash N50°E 22.39'


The selected location is accepted by me and is generally accepted by professional surveyors as the best available evidence of the position of the original corner.

C. Description of monument for corner and accessories established to perpetuate locating the position of the corner:

M-6 Standard Kent County Monument

Nail & KC Remon. tag W. side 8" Hickory	S25°E	49.12'
Nail & KC Remon. tag SE side 12" Maple	S50°W	26.97'
Nail & KC Remon. tag NE side 12" Hickory	N30°W	40.65'
Nail & KC Remon. tag NW side 12" Ash	N50°E	22.39'

C/L old RR grade is East 10'±

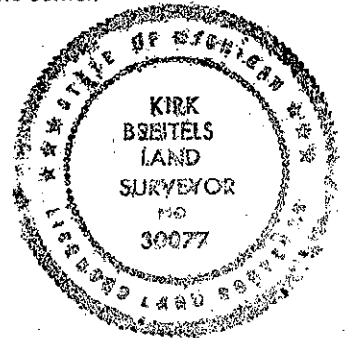

Signed by *Kirk Breitels*
 Surveyor's Michigan License No. 30077

Date 3/27/97

P.A. 345 1990 KENT COUNTY
 PEER APPROVED 3/27/97
 CHAIRMAN *Harry Hubert*