

SURVEY & REMONUMENTATION

KENT COUNTY REMONUMENTATION

MAR 03 1998

LAND CORNER RECORDATION CERTIFICATE
Filing Requirement of Act 74, Mich. P.A. 1970

STATE OF MICHIGAN
COUNTY OF KENT
RECEIVED FOR RECORD
97 APR 29 AM 8:20
REG. OF DEEDS
Lucy Bond

For corners in **SECTION**
KENT COUNTY

Located In:	Corner Code #
T 5N R 9W	M-8
T R	
T R	
T R	
T R	
S T R	
S T R	
S T R	
S T R	

9789

Register of Deeds Stamp & File Number

- Public Land Survey
- Property Controlling in Section
- Miscellaneous Property in Sec.
- Lot No. _____, Recorded Plat _____
- Private Claims _____

	A	B	C	D	E	F	G	H	I	J	K	L	M
1													
2	6		5		4		3		2		1		
3													
4	7		8		9		10		11		12		
5													
6	18		17		16		15		14		13		
7													
8	19		20		21		22		23		24		
9													
10	30		29		28		27		26		25		
11													
12	31		32		33		34		35		36		
13													

Kirk Breitels, in a field survey on Feb. 6, 1997 do hereby state that under requirements of P.A. 74, Michigan P.A. of 1970, the corner points mentioned in lines 1 and 2 above were in conformance with regulations and rules therefore as required in the current manual of survey instructions of the United States Department of the Interior, Bureau of Land Management or by a decree of a Court of Law and/or that the corner points mentioned in lines 3, 4 and 5 above were in conformance with the rules of the Michigan Board of Land Surveyors or by a Decree of a Court of Law; established, re-established, monumented, recovered, found as expressed below:

NOTE: Not more than 2 corners, all in the same town and range, may be recorded on this certificate.

A. Description of original monument and accessories and/or subsequent restoration:

M-8	1830	GLO	Mullett	Set Post
	1962	Kent Co. Wit.		1/2" Rod next to fence post
	1984	LCRC #3761	Bonnema	Set Capped Rerod
	1985	LCRC #6656	Jonker	Set Kent County Monument

The position of this corner was previously approved by the Kent County Remonumentation Peer Group, monumented by Robert J. Jonker on 3/6/85 and was recorded per LCRC #6656.

B. Description of corner evidence found and/or method applied in restoring or reestablishing corner:

M-8 Found standard Kent Co. Mon. (Harrison) per witnesses from above LCRC as set by Robert J. Jonker in place of the Capped Rerod (Exxel) he found. Said Rerod checks with LCRC #3761 and Medema & VanKooten survey information.

LCRC #6656

Nail & KC Remon. tag NE side 28" Maple	N50°W	54.43'
Nail & KC Remon. tag E. side 5" Elm	S10°W	72.65'
SE corner RR rail corner post	N65°W	44.09'
SW corner I-beam corner post	N80°E	46.63'


Meas. N. to NE corner 2639.03' and fence line to East is North 7'
The selected location is accepted by me and is generally accepted by professional surveyors as the best available evidence of the position of the original corner.

C. Description of monument for corner and accessories established to perpetuate locating the position of the corner:

M-8 Standard Kent County Monument

Nail & KC Remon. tag NE side 30" Maple	N50°W	54.43'
SE corner RR rail corner post	N65°W	44.12'
SW corner I-beam corner post	N80°E	46.63'
Nail & KC Remon. tag NW side 10" Maple	S45°W	35.68'

Fence line to East is North 7'±

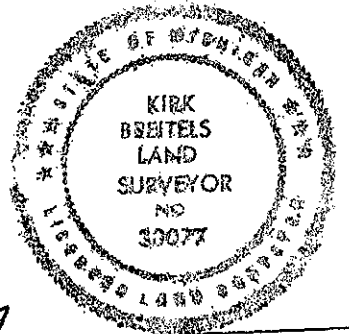

Signed by *Kirk Breitels*
Surveyor's Michigan License No. 30077

Date 3/27/97

P.A. 345 1990 KENT COUNTY
PEER APPROVED 3/27/97
CHAIRMAN *Harry Tuberville*