

SURVEY & REMONUMENTATION

MAR 03 1998

KENT COUNTY REMONUMENTATION

LAND CORNER RECORDATION CERTIFICATE
Filing Requirement of Act 74, Mich. P.A. 1970

STATE OF MICHIGAN
COUNTY OF KENT
RECORDED FOR RECORD
97 DEC -8 AM 10:41
REG. OF DEEDS
Lucy Spauld

For corners in

SECTION

KENT COUNTY (County)	Located In:	Corner Code #
1. Public Land Survey	T 5N R 9W	M-9
	T R	
	T R	
	T R	
2. Property Controlling in Section	S T R	
	S T R	
3. Miscellaneous Property in Sec.	S T R	
	S T R	

10347

Register of Deeds Stamp & File Number

4. Lot No. _____, Recorded Plat _____
5. Private Claims _____

I, Kirk Breitels, in a field survey on June 5, 19 97 do hereby state that under requirements of P.A. 74, Michigan P.A. of 1970, the corner points mentioned in lines 1 and 2 above were in conformance with regulations and rules therefore as required in the current manual of survey instructions of the United States Department of the Interior, Bureau of Land Management or by a decree of a Court of Law and /or that the corner points mentioned in lines 3, 4 and 5 above were in conformance with the rules of the Michigan Board of Land Surveyors or by a Decree of a Court of Law; established, re-established, monumented, recovered, found as expressed below:

NOTE: Not more than 2 corners, all in the same town and range, may be recorded on this certificate.

	A	B	C	D	E	F	G	H	I	J	K	L	M
1													
2	6		5		4		3		2		1		
3													
4	7		8		9		10		11		12		
5													
6	18		17		16		15		14		13		
7													
8	19		20		21		22		23		24		
9													
10	30		29		28		27		26		25		
11													
12	31		32		33		34		35		36		
13													

A. Description of original monument and accessories and/or subsequent restoration:

M-9 1830---GLO---Mullett---Set Post
---Williams & Works---Old RR map indicates Stone at NE cor. 25, 5-9 Iron at NW cor. 30, 5-8, 12.50' North of Stone (GLO 12.54'). Map also show C/L plank road E-W 5.0' North of Stone at NE 25. Hwy. ROW book for Kent Co. shows C/L ROW (West) = Sec. line. Hwy. ROW book for Ionia Co. shows C/L ROW (East) is 6.50' South of NW cor. Sec. 30, 5-8.
1944---Kent Co. Wits.---1" Iron
1985---Survey---Jonker---PK Nail 12.5' S. of Mon. Box
1995---Survey---Exxel Eng.---PK Nail 12.54' S. of Iron in Mon. Box

B. Description of corner evidence found and/or method applied in restoring or reestablishing corner:

M-9 Found 1" Iron per Kent Co. Wits. in Mon. Box 5.0' N. of the C/L of Hwy. M-50 E-W. Also found PK Nail 12.54' S. of Iron in Mon. Box and 7.5' S. of C/L of Hwy. M-50.


Determined that the 1" Iron in Mon. Box is the NW cor. Sec. 30, 5-8 per old information of RR maps and Ionia Co. Hwy. ROW book and Ionia Co. LCRC #1-85.

The PK Nail 12.54' South of the 1" Iron in Mon. Box has been used as M-9 in surveys by Exxel Eng. and Rob Jonker.

The PK Nail is accepted by me and is generally accepted by professional surveyors as the best available evidence of the original corner.

C. Description of monument for corner and accessories established to perpetuate locating the position of the corner:

M-9 Set Standard Kent Co. Monument (Harrison) in place of the PK Nail.
Set Nail & KC Remon. tag NE side 12" Maple N50°W 74.05'
SE corner I-beam post N40°W 63.18'
Set Nail & KC Remon. tag NW side P. Pole N45°E 66.23'
PK in top E. end 12" C.M.P. S70°E 23.66'
NW corner "Ionia County" sign post S80°W 35.78'

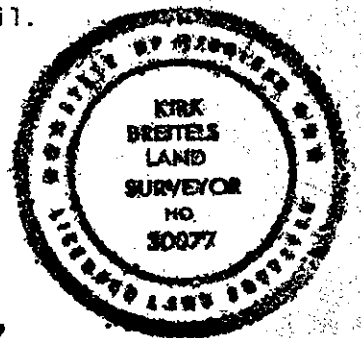

Signed by *Kirk Breitels*
Surveyor's Michigan License No. 30077

Date 11/6/97

P.A. 345 1990 KENT COUNTY

PEER APPROVED 12/24/97
CHAIRMAN *Harry Fisher*

FORM APPROVED BY MICHIGAN STATE BOARD OF PROFESSIONAL SURVEYORS, JAN. 28, 1971
REVISED MAY 14, 1975
REVISED JAN., 1983
REVISED OCT., 1985