

**SURVEY & REMONUMENTATION**

\$7.00  
\$2.00

FEB 14 1997

**LAND CORNER RECORDATION CERTIFICATE**  
Filing Requirement of Act 74, Mich. P.A. 1970  
KENT COUNTY REMONUMENTATION

For corners in **COMMISSION**

Kent (County)	Located in: Caledonia Township	Corner Code #
1. Public Land Survey	T <u>5N</u> R <u>10W</u>	<u>A-2</u>
	T _____ R _____	_____
	T _____ R _____	_____
	T _____ R _____	_____
2. Property Controlling in Section	S _____ T _____ R _____	_____
	S _____ T _____ R _____	_____
3. Miscellaneous Property in Sec.	S _____ T _____ R _____	_____
	S _____ T _____ R _____	_____
4. Lot No. _____, Recorded Plat _____		
5. Private Claims _____		


STATE OF MICHIGAN  
COUNTY OF KENT  
RECEIVED FOR RECORD

96 NOV - 8 AM 9:15

REG. OF DEEDS  
*Lucy St. Land*

**9431**

Register of Deeds Stamp & File Number

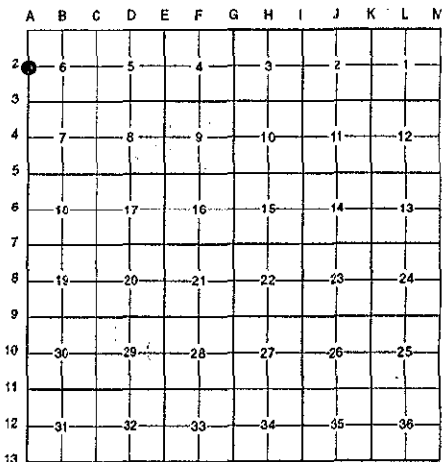

I, Randy Kolehouse, in a field survey on April 9 19 96, do hereby certify that under requirements of P.A. 74 Michigan P.A. of 1970, the corner points mentioned in lines 1 and 2 above were in conformance with regulations and rules therefore as required in the current manual of survey instructions of the United States Department of the interior, Bureau of Land Management or by a decree of a Court of Law and/or that the corner points mentioned in lines 3, 4 and 5 above were in conformance with the rules of the Michigan Board of Land Surveyors or by a Decree of a Court of Law; established, re-established, monumented, re-monumented, recovered, found as expressed below:

**NOTE: Not more than 4 corners, all in the same town and range, may be recorded on this certificate.**

A. Description of original monument and accessories and/or subsequent restoration:

A-2 This corner was not originally set by the G.L.O.

Year	Notes	Surveyor	Monument
1941-1962		Williams & Works	1" Iron Pipe
1983	L.C.R.C. #3573	William Byl	Fnd. 1" Iron Pipe / Set K.C. Monument
1991	L.C.R.C. #5921	William Byl	K.C. Monument

This corner is not common with M-2, T5N, R11W.

This corner was originally approved by the Kent County Remonumentation Peer Group and monumented by William Byl on 9/1/83 and was recorded per L.C.R.C. #3573.

B. Description of corner evidence found and/or method applied in restoring or reestablishing corner:

A-2 Found a Standard Kent County Monument 1' East of the C/L of Patterson Avenue running North and South and 5' South of a ditch running East per L.C.R.C.'s #3573 and #5921 as set by William Byl in place of a 1" iron pipe he found 68.70' South of E 1/4, Sec. 1, which checked the 1941-1962 Williams & Works' notes.

L.C.R.C. #3573

L.C.R.C. #5921

L.C.R.C. #3573	L.C.R.C. #5921
Nail & tag, N sd. 12" Hickory N 55° W 29.45'	Nail & KC Remon. tag N. side 12" Hickory (Walnut) N 55° W 29.45'
Nail & tag, N sd. 12" Hickory s 60° W 29.56'	Nail & KC Remon. tag N. side 12" Hickory (Walnut) S 60° W 29.56' (m. 29.45')
Nail & tag, E sd. 12" Hickory S 15° W 100.14'	Nail & KC Remon. tag E. side 12" Hickory (Walnut) S 15° W 100.14' (m. 100.12')
Nail & tag, N sd. Power pole N 90° E 44.58'	Nail & KC Remon. tag N. side Power Pole N 90° E 44.58' (m. 44.56')
	Kent Co. Mon. ( E 1/4 cor. Sec. 1-5-11) N 00° E 68.73'

The selected location is accepted by me and is generally accepted by professional surveyors as the best available evidence of the position of the original corner.

C. Description of monument for corner and accessories established to perpetuate locating the position of the corner:

A-2 Standard Kent County Monument

- Nail & K.C. remon. tag on N side 12" Walnut N 55° W 29.45'
- Nail & K.C. remon. tag on N side 12" Walnut S 60° W 29.45'
- Nail & K.C. remon. tag on E side 12" Walnut S 15° W 100.12'
- Nail & K.C. remon. tag on N side P. pole N 90° E 44.56'
- K.C. Mon. E 1/4 Sec. 1, T5N R11W, N 00° E 68.73'

Signed by Randy J. Kolehouse  
EARTH TECH

Date 10/8/96

Surveyor's Michigan License No. 25854

P.A. 345 1990 KENT COUNTY  
PEER APPROVED 7/25/96  
CHAIRMAN Harry Huber

