

\$7.00  
\$2.00

**SURVEY & REMONUMENTATION**

FEB 14 1997

**COMMISSION**

**LAND CORNER RECORDATION CERTIFICATE**  
Filing Requirement of Act 74, Mich. P.A. 1970  
KENT COUNTY REMONUMENTATION

For corners in

	<u>Kent</u> (County)	Located in: Caledonia Township	Corner Code #
1. Public Land Survey		T <u>5N</u> R <u>10W</u>	<u>A-3</u>
		T _____ R _____	_____
		T _____ R _____	_____
		T _____ R _____	_____
2. Property Controlling in Section	S _____	T _____ R _____	_____
	S _____	T _____ R _____	_____
3. Miscellaneous Property in Sec.	S _____	T _____ R _____	_____
	S _____	T _____ R _____	_____
4. Lot No. _____, Recorded Plat _____			
5. Private Claims _____			

STATE OF MICHIGAN  
COUNTY OF KENT  
RECEIVED FOR RECORD


96 NOV - 8 AM 9:15

REG. OF DEEDS  
9432

Register of Deeds Stamp & File Number

I, Randy Kolehouse, in a field survey on January 24 19 96, do hereby certify that under requirements of P.A. 74 Michigan P.A. of 1970, the corner points mentioned in lines 1 and 2 above were in conformance with regulations and rules therefore as required in the current manual of survey instructions of the United States Department of the interior, Bureau of Land Management or by a decree of a Court of Law and/or that the corner points mentioned in lines 3, 4 and 5 above were in conformance with the rules of the Michigan Board of Land Surveyors or by a Decree of a Court of Law; established, re-established, monumented, re-monumented, recovered, found as expressed below:

**NOTE: Not more than 4 corners, all in the same town and range, may be recorded on this certificate.**

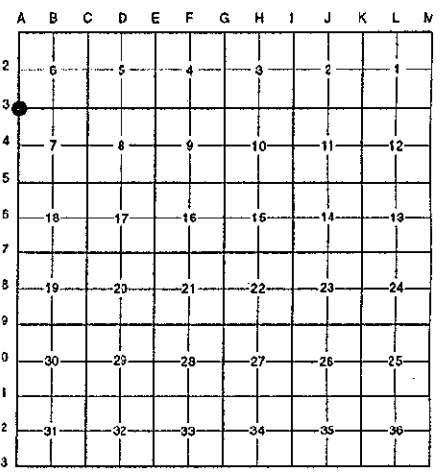

A. Description of original monument and accessories and/or subsequent restoration:

A-3	1831	G.L.O. Notes	Mullett	Set Post
	1962	Witness Map	K.C. Surveyor	1" Iron
	1983	L.C.R.C. #3499	William Byl	Fnd. 1" Iron Pipe / Set K.C. Monument in Mon. Box
	1991	L.C.R.C. #5922	William Byl	K.C. Monument
	1993	L.C.R.C. #7151	Glaza & Associates	K.C. Monument

Note: This corner is not common with M-3, T5N, R11W.

This corner was originally approved by the Kent County Remonumentation Peer Group and monumented by William Byl on 9/19/83 and was recorded per L.C.R.C. #3499.

B. Description of corner evidence found and/or method applied in restoring or reestablishing corner:

A-3 Found a Standard Kent County Monument 9' South of the C/L intersection of 68th Street (bit.) running East and West and Patterson Avenue (bit.) running North and South per L.C.R.C.'s #3499, #5922 and #7151 as set by William Byl in place of 1" iron pipe in a monument box he found which checked the K.C. Surveyor's records.

L.C.R.C. #3499

L.C.R.C. #5922

L.C.R.C. #7151

Nail & tag, W. sd. Power pole N 25° W 99.07'	Nail & KC Remon. tag W. side Power Pole N 25° W 99.07'	Nail & K.C. remon tag in SW side 14" Maple S 45° E 78.75' (m. 79.01')
Nail & tag, W. sd. 10" Maple S 45° E 78.83'		
NE cor. brick veneer, Hse. # 6815 S 60° W 172.45'	Nail & KC Remon. tag W. side 12" Maple S 45° E 78.75'	NE corner brick veneer house #6815 S 60° W 172.35' (m. 172.30')
Kent County Monument, SE cor. Sec. 1, 5-11, N 00° W 68.75'	NE cor. brick veneer Hse. 6815 S 60° W 172.35'	Kent Co Monument (SE cor. Sec 1, 5-11) N 00° W 68.75'
	Kent County Monument, SE cor., Sec. 1, 5-11 N 00° W 68.75'	Nail & K.C. remon tag in SE side P. pole S 45° W 42.56' (m. 42.28')
	Nail & KC Remon. tag SE side Power Pole S 45° W 42.36'	Nail & K.C. remon tag in SW side P. pole N 25° W 99.55' (m. 99.48')
		Centerline of 68th Street North 9'

The selected location is accepted by me and is generally accepted by professional surveyors as the best available evidence of the position of the original corner.

C. Description of monument for corner and accessories established to perpetuate locating the position of the corner:

A-3 Standard Kent County Monument

Nail & K.C. remon. tag on SW side 14" Maple N 10° W 132.84'	NE cor. brick veneer S 60° W 172.30'
Nail & K.C. remon. tag on W side P. pole N 25° W 99.48'	K.C. Mon. SE 1, 5-11, N 00° E 68.75'
Nail & K.C. remon. tag on S side P. pole N 70° E 99.15'	
Nail & K.C. remon. tag on W side 12" Maple S 45° E 79.01'	
Nail & K.C. remon. tag on SE side P. pole S 45° W 42.28'	
Nail & K.C. remon. tag on N side P. pole S 70° E 49.18'	

Signed by Randy J. Kolehouse  
EARTH TECH

Date 10/8/96

Surveyor's Michigan License No. 25854

P.A. 345 1990 KENT COUNTY

PEER APPROVED 7/29/96  
CHAIRMAN Harry Huber

