

SURVEY & REMONUMENTATION

FEB 14 1997

COMMISSION

LAND CORNER RECORDATION CERTIFICATE
Filing Requirement of Act 74, Mich. P.A. 1970
KENT COUNTY REMONUMENTATION


For corners in

Kent (County)	Located in: Caledonia Township	Corner Code #
1. Public Land Survey	T <u>5N</u> R <u>10W</u>	<u>A-5</u>
	T _____ R _____	_____
	T _____ R _____	_____
	T _____ R _____	_____
2. Property Controlling in Section	S _____ T _____ R _____	_____
3. Miscellaneous Property in Sec.	S _____ T _____ R _____	_____

STATE OF MICHIGAN
 COUNTY OF KENT
 RECEIVED FOR RECORD
 96 NOV -8 AM 9:15
 REG. OF DEEDS
Lucy St...
9434
 Register of Deeds Stamp & File Number

4. Lot No. _____, Recorded Plat _____
 5. Private Claims _____

I, Randy Kolehouse, in a field survey on January 24 19 96, do hereby certify that under requirements of P.A. 74 Michigan P.A. of 1970, the corner points mentioned in lines 1 and 2 above were in conformance with regulations and rules therefore as required in the current manual of survey instructions of the United States Department of the interior, Bureau of Land Management or by a decree of a Court of Law and/or that the corner points mentioned in lines 3, 4 and 5 above were in conformance with the rules of the Michigan Board of Land Surveyors or by a Decree of a Court of Law; established, re-established, monumented, re-monumented, recovered, found as expressed below:

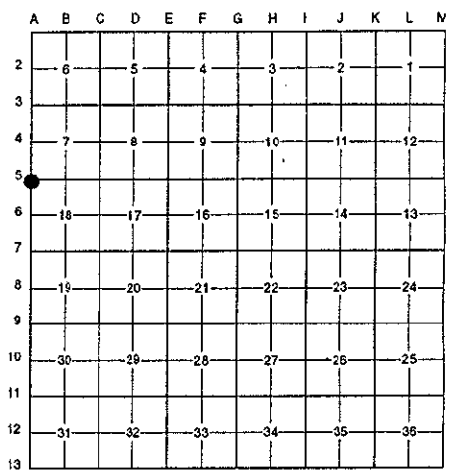

NOTE: Not more than 4 corners, all in the same town and range, may be recorded on this certificate.

A. Description of original monument and accessories and/or subsequent restoration:

A-5	1831	G.L.O. Notes	Mullett	Set Post
	1964	Witness Map	K.C. Surveyor	Monument Box
	1973	L.C.R.C. #512	Exxel Engineering	Monument Box with 1" Iron
	19xx	L.C.R.C. #957	McPherson	3/4" Pipe in Mon. Box
	1983	L.C.R.C. #3521	William Byl	Fnd. 1" Iron Pipe in Mon. Box / Set K.C. Monument
	1991	L.C.R.C. #5924	William Byl	K.C. Monument
	1993	L.C.R.C. #7149	Glaza & Associates	K.C. Monument

Note: This corner is not common with M-5, T5N, R11W.

This corner was originally approved by the Kent County Remonumentation Peer Group and monumented by William Byl on 8/29/83 and was recorded per L.C.R.C. #3521.

B. Description of corner evidence found and/or method applied in restoring or reestablishing corner:

A-5 Found a Standard Kent County Monument 10' North of the C/L intersection of 76th Street (bit.) running East and West and Patterson Avenue (bit.) running North and South per L.C.R.C.'s #3521, #5924 and #7149 as set by William Byl in place of a 1" iron pipe he found in a monument box 0.04' West of East line of Gaines Township which checked L.C.R.C.'s #512 and #957 and the K.C. Surveyor's records.

L.C.R.C. #3521

L.C.R.C. #5924

L.C.R.C. #7149

Nail & tag, South side Power pole N 65 E 76.79'	Nail & KC Remon. tag N. side Power Pole N 65° E 76.75'	Nail & K.C. remon tag in North side P. pole N 65° E 76.75' (m. 76.73')
SW cor. concrete headwall N 10 W 81.98'	SW cor. concrete headwall N 10° W 81.98'	SW corner concrete headwall N 10° W 81.98' (m. 82.02')
NW cor. MBT pedestal, at ground level S 45 E 39.75'	NW cor. MBT pedestal, at ground level S 45° E 39.85'	SE corner, Sec 12, 5-11 (Kent County Monument) N 00° E 35.44'
SE cor. Sec. 12, 5-11, (Kent County Mon.) N 00 E 35.44'	SE cor. Sec. 12, 5-11, (Kent County Mon.) N 00° E 35.44'	Nail & K.C. remon tag in North side guy pole N 85° W 80.11' (m. 80.04')
	Nail & KC Remon. tag N. side Guy Pole N 85° W 80.11'	Chisel mark on East end of concrete culvert N 20° E 86.08' (m. 86.08')

The selected location is accepted by me and is generally accepted by professional surveyors as the best available evidence of the position of the original corner.

C. Description of monument for corner and accessories established to perpetuate locating the position of the corner:

A-5 Standard Kent County Monument	Nail & K.C. remon. tag on N side P. pole N 65° E 76.73'	Chisel mark on E end conc. culv. N 20° E 86.08'
	SW cor. conc. headwall N 10° W 82.02'	K.C. Mon. SE Sec. 12, T5N, R11W, N 00° E 35.44'
	Nail & K.C. remon. tag on N side Guy pole N 85° W 80.04'	

Signed by Randy J. Kolehouse Date 10/18/96
 EARTH TECH

Surveyor's Michigan License No. 25854

P.A. 345 1990 KENT COUNTY
 PEER APPROVED 7/25/96
 CHAIRMAN [Signature]

FORM APPROVED BY MICHIGAN STATE BOARD OF LAND SURVEYORS, JAN 29, 1971
 REVISED MAY 1985
 REVISED JAN 1988

