

SURVEY & REMONUMENTATION

FEB 14 1997

COMMISSION

LAND CORNER RECORDATION CERTIFICATE
Filing Requirement of Act 74, Mich. P.A. 1970
KENT COUNTY REMONUMENTATION

For corners in

<u>Kent</u> (County)	Located in: Caledonia Township	Corner Code #
1. Public Land Survey	T. <u>5N</u> R. <u>10W</u>	<u>A-8</u>
	T. _____ R. _____	_____
	T. _____ R. _____	_____
	T. _____ R. _____	_____
2. Property Controlling in Section	S. _____ T. _____ R. _____	_____
	S. _____ T. _____ R. _____	_____
3. Miscellaneous Property in Sec.	S. _____ T. _____ R. _____	_____
	S. _____ T. _____ R. _____	_____

STATE OF MICHIGAN
 COUNTY OF KENT
 RECEIVED FOR RECORD

96 NOV -8 AM 9:15

REG. OF DEEDS
 9437

Register of Deeds Stamp & File Number

4. Lot No. _____, Recorded Plat _____
 5. Private Claims _____

I, Randy Kolehouse, in a field survey on January 24 19 96, do hereby certify that under requirements of P.A. 74 Michigan P.A. of 1970, the corner points mentioned in lines 1 and 2 above were in conformance with regulations and rules therefore as required in the current manual of survey instructions of the United States Department of the interior, Bureau of Land Management or by a decree of a Court of Law and/or that the corner points mentioned in lines 3, 4 and 5 above were in conformance with the rules of the Michigan Board of Land Surveyors or by a Decree of a Court of Law; established, re-established, monumented, re-monumented, recovered, found as expressed below:

NOTE: Not more than 4 corners, all in the same town and range, may be recorded on this certificate.

A. Description of original monument and accessories and/or subsequent restoration:

A-8 This corner was not originally set by the G.L.O.

Date	Notes	Surveyor	Monument
1910-1946	Notes	Williams & Works	Wagon Axle
1940	Witness Map	K.C. Surveyor	3/4" Iron
1973	L.C.R.C. #529	Exxel Engineering	Reset 3/4" Iron
1983	L.C.R.C. #3523	William Byl	Fnd. 1" x 18" Iron Pipe / Set K.C. Monument
1991	L.C.R.C. #5927	William Byl	K.C. Monument
1993	L.C.R.C. #7146	Glaza & Associates	K.C. Monument

Note: This corner is not common with M-8, T5N, R11W.

This corner was originally approved by the Kent County Remonumentation Peer Group and monumented by William Byl on 9/27/83 and was recorded per L.C.R.C. #3523.

B. Description of corner evidence found and/or method applied in restoring or reestablishing corner:

A-8 Found a Standard Kent County Monument in the C/L of Patterson Avenue (bit.) running North and South on line of a fence line running East per L.C.R.C.'s #3523, #5927 and #7146 as set by William Byl in place of a 1" x 18" iron pipe over a 1" iron (wagon axle ?) 36" deep 13.02' South of M-8, T5N, R11W, and on the West line of Gaines Township which checked L.C.R.C. #529, the 1910-1946 Williams & Works' notes, and the K.C. Surveyor's records.

L.C.R.C. #3523

L.C.R.C. #7146

L.C.R.C. #3523	L.C.R.C. #7146
Nail & tag, E sd. 20" Oak S 20 W 98.00'	Nail & K.C. remon tag in East side 24" Oak S 20° W 97.90'
Nail & tag, S sd. Power pole N 55 W 43.30'	Nail & K.C. remon tag in South side P. pole N 55° W 43.30' (m. 43.22')
Nail & tag, N sd. 12" twin Hickory N 85 E 63.14'	Nail & K.C. remon tag in North side 12" Twin Hickory (Ash) N 85° E 63.14'
Nail & tag, N sd. 6" Maple N 60 E 48.63'	Nail & K.C. remon tag in North side 10" Maple N 60° E 48.63' (m. 48.68')
East 1/4 Cor. Sec. 24, 5-11, N 00 E 39.02'	East 1/4 corner, Sec 24, 5-11 (Kent Co Monument) N 00° E 39.01'
	Nail & K.C. remon tag in East side 12" Ash N 10° W 109.48' (m. 109.46')

The selected location is accepted by me and is generally accepted by professional surveyors as the best available evidence of the position of the original corner.


C. Description of monument for corner and accessories established to perpetuate locating the position of the corner:

A-8 Standard Kent County Monument

- Nail & K.C. remon. tag on E side 24" Oak S 20° W 97.90'
- Nail & K.C. remon. tag on S side P. pole N 55° W 43.22'
- Nail & K.C. remon. tag on N side 12" Twin Ash N 85° E 63.14'
- Nail & K.C. remon. tag on N side 6" Maple N 60° E 48.68'
- K.C. Mon. E 1/4 Sec. 24, T5N, R11W, N 00° E 39.01'
- Nail & K.C. remon. tag on E side 12" Ash N 10° W 109.46'

Signed by Randy J. Kolehouse
 EARTH TECH

Date 10/8/96

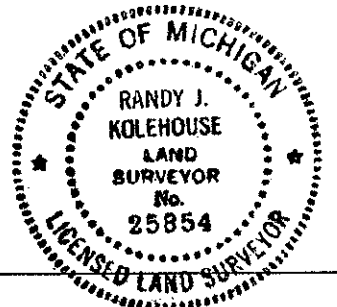

Surveyor's Michigan License No. 25854

P.A. 345 1990 KENT COUNTY

PEER APPROVED 7/25/96
 CHAIRMAN Harry Huber