

SURVEY & REMONUMENTATION

FEB 14 1997

COMMISSION

LAND CORNER RECORDATION CERTIFICATE

Filing Requirement of Act 74, Mich. P.A. 1970

KENT COUNTY REMONUMENTATION

For corners in

Kent (County)	Located in: Caledonia Township	Corner Code #
1. Public Land Survey	T <u>5N</u> R <u>10W</u>	<u>A-9</u>
	T _____ R _____	_____
	T _____ R _____	_____
	T _____ R _____	_____
2. Property Controlling in Section	S _____ T _____ R _____	_____
	S _____ T _____ R _____	_____
3. Miscellaneous Property in Sec.	S _____ T _____ R _____	_____
	S _____ T _____ R _____	_____

STATE OF MICHIGAN
COUNTY OF KENT
RECEIVED FOR RECORD

96 NOV -8 AM 9:15

REG. OF DEEDS

W. J. Kolehous


9438

Register of Deeds Stamp & File Number

4. Lot No. _____, Recorded Plat _____
5. Private Claims _____

I, Randy Kolehous, in a field survey on January 24 19 96, do hereby certify that under requirements of P.A. 74 Michigan P.A. of 1970, the corner points mentioned in lines 1 and 2 above were in conformance with regulations and rules therefore as required in the current manual of survey instructions of the United States Department of the interior, Bureau of Land Management or by a decree of a Court of Law and/or that the corner points mentioned in lines 3, 4 and 5 above were in conformance with the rules of the Michigan Board of Land Surveyors or by a Decree of a Court of Law; established, re-established, monumented, re-monumented, recovered, found as expressed below:

NOTE: Not more than 4 corners, all in the same town and range, may be recorded on this certificate.

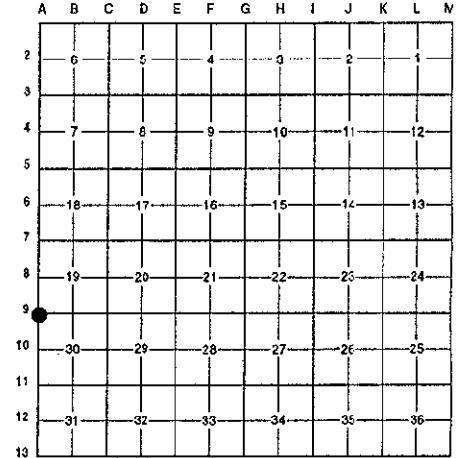

A. Description of original monument and accessories and/or subsequent restoration:

A-9	1831	G.L.O. Notes	Mullett	Set Post
	1910-1948	Notes	Williams & Works	Stone/Iron
	1918	Witness Map	K.C. Surveyor	Stone
	1973	L.C.R.C. #529	Exxel Engineering	1/2" Iron Pipe
	1983	L.C.R.C. #3524	William Byl	Fnd. 3/4" Iron Pipe / Set K.C. Monument
	1991	L.C.R.C. #5928	William Byl	K.C. Monument
	1993	L.C.R.C. #7147	Glaza & Associates	K.C. Monument

Note: This corner is not common with M-9, T5N, R11W.

This corner was originally approved by the Kent County Remonumentation Peer Group and monumented by William Byl on 9/29/83 and was recorded per L.C.R.C. #3524.

B. Description of corner evidence found and/or method applied in restoring or reestablishing corner:

A-9 Found a Standard Kent County Monument in the C/L of Patterson Avenue (bit.) running North and South and 14' South of the C/L of 92nd Street (bit.) running East and West per L.C.R.C.'s #3524, #5928 and #7147 as set by William Byl in place of a 3/4" iron pipe he found 28.67' South of M-9, 5-11 (Kent Co. Mon.) which checked L.C.R.C. #529, Williams & Works notes from 1910-1948, and the K.C. Surveyor's records.

L.C.R.C. #3524

Nail & tag, E sd. Power pole S 15° W 126.22'
Nail & tag, S sd. Power pole N 45° E 80.11'
"X" cut in top of West end 18" concrete culvert N 10° W 105.37'
"X" cut in top of East end 18" concrete culvert N 10° E 105.00'
SE cor. Sec. 24, 5-11, (Kent County Monument) N 00° E 28.68'
C/L 92nd St. is North 14' ±

L.C.R.C. #7147

K.C. remon tag & nail in (3' higher) East side P. pole S 15° W 126.17' (m. 126.23')
K.C. remon tag & nail in (4' higher) South side P. pole N 45° E 80.14' (m. 80.10')
K.C. remon tag & nail in NE side 10" Elm N 40° W 96.90' (m. 96.74')
K.C. remon tag & nail in SE side guy pole S 75° W 44.30' (m. 45.31')
SE corner, Sec 25, 5-11 (Kent Co Monument) N 00° E 28.68' (m. 28.67')

The selected location is accepted by me and is generally accepted by professional surveyors as the best available evidence of the position of the original corner.

C. Description of monument for corner and accessories established to perpetuate locating the position of the corner:

A-9 Standard Kent County Monument

Nail & K.C. remon. tag on E side P. pole 3' high S 15° W 126.23'
Nail & K.C. remon. tag on S side P. pole N 45° E 80.10'
Nail & K.C. remon. tag on NE side 10" Elm N 40° W 96.74'
New Nail & K.C. remon. tag on NW side Guy pole S 75° W 45.31'
K.C. Mon. Sec. 24, T5N, R11W, N 00° E 28.67'

Signed by *Randy J. Kolehous* Date 10/8/96

Surveyor's Michigan License No. 25854

P.A. 345 1990 KENT COUNTY

PEER APPROVED 12/25/96

CHAIRMAN *W. J. Kolehous*

