

**SURVEY & REMONUMENTATION**  
 FEB 14 1997  
 COMMISSION

**LAND CORNER RECORDATION CERTIFICATE**  
**Filing Requirement of Act 74, Mich. P.A. 1970**  
**KENT COUNTY REMONUMENTATION**

For corners in

Kent (County)	Located in: Caledonia Township	Corner Code #
1. Public Land Survey	T <u>5N</u> R <u>10W</u>	<u>A-10</u>
	T _____ R _____	_____
	T _____ R _____	_____
	T _____ R _____	_____
2. Property Controlling in Section	S _____ T _____ R _____	_____
	S _____ T _____ R _____	_____
3. Miscellaneous Property in Sec.	S _____ T _____ R _____	_____
	S _____ T _____ R _____	_____

STATE OF MICHIGAN  
 COUNTY OF KENT  
 RECEIVED FOR RECORD


96 NOV -8 AM 9:16

REG. OF DEEDS  
*Lucy Standa*  
**9439**

Register of Deeds Stamp & File Number

4. Lot No. \_\_\_\_\_, Recorded Plat \_\_\_\_\_  
 5. Private Claims \_\_\_\_\_

I, Randy Kolehouse, in a field survey on January 24 19 96, do hereby certify that under requirements of P.A. 74 Michigan P.A. of 1970, the corner points mentioned in lines 1 and 2 above were in conformance with regulations and rules therefore as required in the current manual of survey instructions of the United States Department of the interior, Bureau of Land Management or by a decree of a Court of Law and/or that the corner points mentioned in lines 3, 4 and 5 above were in conformance with the rules of the Michigan Board of Land Surveyors or by a Decree of a Court of Law; established, re-established, monumented, re-monumented, recovered, found as expressed below:

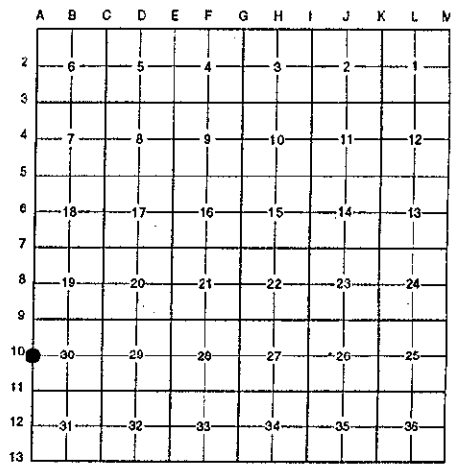

NOTE: Not more than 4 corners, all in the same town and range, may be recorded on this certificate.

A. Description of original monument and accessories and/or subsequent restoration:

A-10 This corner was not originally set by the G.L.O.

Year	Notes	Surveyor	Monument
1964	Notes	Williams & Works	Iron
1952	Witness Map	K.C. Surveyor	Iron
1978	L.C.R.C. #1161	Exxel Engineering	1" Iron
1983	L.C.R.C. #3525	William Byl	Fnd. 1" Iron Pipe / Set K.C. Monument
1991	L.C.R.C. #5929	William Byl	K.C. Monument
1993	L.C.R.C. #7143	Glaza & Associates	K.C. Monument

Note: This corner is not common with M-10, T5N, R11W.

This corner was originally approved by the Kent County Remonumentation Peer Group and monumented by William Byl on 9/29/83 and was recorded per L.C.R.C. #3525.

B. Description of corner evidence found and/or method applied in restoring or reestablishing corner:

A-10 Found a Standard Kent County Monument 5' West of the C/L of Patterson Avenue (bit.) running North and South and 5' South of brush row running East per L.C.R.C.'s #3525, #5929, and #7143 as set by William Byl in place of a 1" iron pipe he found 0.6' East of the East line of Gaines Township and 13.32' South of the East 1/4 corner of Sec. 25, 5-11, which checked L.C.R.C. #1161, Williams & Works's notes and the K.C. Surveyor's records.

L.C.R.C. #3525

L.C.R.C. #7143

L.C.R.C. #3525	L.C.R.C. #7143
Nail & tag, E sd. Power pole N 20° W 119.08'	Nail & K.C. remon tag in East side P. pole N 20° W 119.08'
Nail & tag, W sd. 8" Hickory S 10° E 136.10'	Nail & K.C. remon tag in West side 12" Hickory S 10° E 136.22' (m. 136.10')
"x" cut on top of S. end 18" culvert N 60° E 26.23'	East 1/4 corner, Sec 25, 5-11 (Kent Co Monument N 00° E 13.30')
"x" cut on top of N. end 18" culvert N 30° E 46.87'	Centerline of road 5' ± East
East 1/4 cor. Sec. 25, 5-11, (Kent County Monument) N 00° E 13.32'	

The selected location is accepted by me and is generally accepted by professional surveyors as the best available evidence of the position of the original corner.


C. Description of monument for corner and accessories established to perpetuate locating the position of the corner:

A-10 Standard Kent County Monument

- Nail & K.C. remon. tag on E side P. pole N 20° W 119.08'
- Nail & K.C. remon. tag on W side 12" Hickory S 10° E 136.10'
- Nail & K.C. remon. tag on S side 14" Elm N 85° E 73.06'
- Nail & K.C. remon. tag on E side P. pole S 10° W 146.87'

Signed by Randy J. Kolehouse  
 EARTH TECH

Date 10/8/96

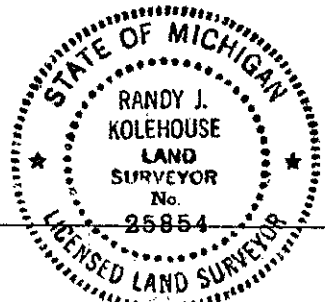

Surveyor's Michigan License No. 25854

P.A. 345 1990 KENT COUNTY  
 PEER APPROVED 7/25/96  
 CHAIRMAN Farris Hebert