

**SURVEY & REMONUMENTATION**  
 \$7.00  
 \$2.00

FEB 14 1997

**LAND CORNER RECORDATION CERTIFICATE**  
 Filing Requirement of Act 74, Mich. P.A. 1970  
 KENT COUNTY REMONUMENTATION

For corners in

Kent  
 (County)

Located in: Caledonia  
 Township

Corner Code #

- |                                    |             |              |             |
|------------------------------------|-------------|--------------|-------------|
| 1. Public Land Survey              | T <u>5N</u> | R <u>10W</u> | <u>A-12</u> |
|                                    | T           | R            |             |
|                                    | T           | R            |             |
|                                    | T           | R            |             |
| 2. Property Controlling in Section | S           | T            | R           |
|                                    | S           | T            | R           |
| 3. Miscellaneous Property in Sec.  | S           | T            | R           |
|                                    | S           | T            | R           |

4. Lot No. \_\_\_\_\_, Recorded Plat \_\_\_\_\_  
 5. Private Claims \_\_\_\_\_

STATE OF MICHIGAN  
 COUNTY OF KENT  
 RECEIVED FOR RECORD  
 96 NOV -8 AM 9:16  
 REG. OF DEEDS  
*W. J. Kolehuse*

**9441**

Register of Deeds Stamp & File Number

I, Randy Kolehuse, in a field survey on January 24 19 96, do hereby certify that under requirements of P.A. 74 Michigan P.A. of 1970, the corner points mentioned in lines 1 and 2 above were in conformance with regulations and rules therefore as required in the current manual of survey instructions of the United States Department of the interior, Bureau of Land Management or by a decree of a Court of Law and/or that the corner points mentioned in lines 3, 4 and 5 above were in conformance with the rules of the Michigan Board of Land Surveyors or by a Decree of a Court of Law; established, re-established, monumented, re-monumented, recovered, found as expressed below:

A	B	C	D	E	F	G	H	I	J	K	L	M
2	6	5	4	3	2	1						
3												
4	7	8	9	10	11	12						
5												
6	18	17	16	15	14	13						
7												
8	19	20	21	22	23	24						
9												
10	30	29	28	27	26	25						
11												
12	31	32	33	34	35	36						
13												

**NOTE: Not more than 4 corners, all in the same town and range, may be recorded on this certificate.**

**A. Description of original monument and accessories and/or subsequent restoration:**

- A-12 This corner is not originally set by the G.L.O.
- |      |                |                    |                              |
|------|----------------|--------------------|------------------------------|
| 1956 | Witness Map    | K.C. Surveyor      | 3/4" Iron                    |
| N/A  | Notes          | Williams & Works   | ???                          |
| 1982 | L.C.R.C. #2932 | Exxel Engineering  | 3/4" Iron / Set RR Spike     |
| 1984 | L.C.R.C. #3737 | William Byl        | RR Spike / Set K.C. Monument |
| 1991 | L.C.R.C. #5931 | William Byl        | K.C. Monument                |
| 1993 | L.C.R.C. #7144 | Glaza & Associates | K.C. Monument                |

Note: This corner is not common with M-12, T5N, R11W.

This corner was originally approved by the Kent County Remonumentation Peer Group and monumented by William Byl on 2/20/84 and was recorded per L.C.R.C. #3737.

**B. Description of corner evidence found and/or method applied in restoring or reestablishing corner:**

A-12 Found a Standard Kent County Monument 1" East of the C/L of Patterson Avenue (bit.) running North and South per L.C.R.C.'s #3737, #5931 and #7144 as set by William Byl in place of a RR spike he found which checked L.C.R.C. #2932, Williams & Works' notes, and the K.C. Surveyor's records.

L.C.R.C. #3737

L.C.R.C. #7144

- Nail & tag, E sd. Power pole N 20° W 89.41'
- Nail & tag, W sd. 12" Maple S 20° E 103.08'
- NW cor. of brick ledge, Indn. of House #10418 S 55° E 107.22'
- Angle iron, on E&W 1/4 line, Sec. 31, N 90° E 33.00'
- Kent Co. Monument (E 1/4 cor. 36-5-11) N 00° E 5.94'

- Nail & K.C. remon tag in East side P. pole N 20° W 89.52' (m. 89.50')
- Nail & K.C. remon tag in West side 14" Maple S 20° E 103.02' (m. 103.00')
- NW corner of brick veneer house #10418 S 55° E 107.12' (m. 107.10')
- Angle iron on E-W 1/4 line, Sec 31 N 90° E 33.00'
- Kent Co Monument (E 1/4 cor, Sec 36-5-11) N 00° E 5.94' (m. 5.97')

The selected location is accepted by me and is generally accepted by professional surveyors as the best available evidence of the position of the original corner.


**C. Description of monument for corner and accessories established to perpetuate locating the position of the corner:**

A-12 Standard Kent County Monument

- Nail & K.C. remon. tag on E side P. pole N 20° W 89.50'
- Nail & K.C. remon. tag on W side 14" Maple S 20° E 103.00'
- NW cor. brick veneer hse. #10418 S 55° E 107.10'
- Angle Iron on E-W 1/4 line 31 N 90° E 33.00'
- K.C. Mon. M-12, T5N, R11W, N 00° E 5.97'

Signed by *Randy J. Kolehuse*  
 EARTH TECH

Date 10/8/96

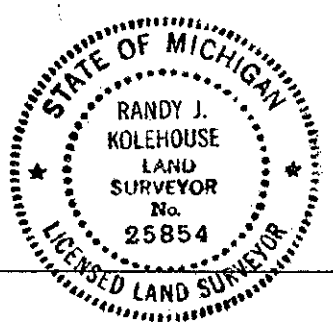

Surveyor's Michigan License No. 25854

P.A. 345 1990 KENT COUNTY  
 PEER APPROVED 7/25/96  
 CHAIRMAN *Harry Huber*