

SURVEY & REMONUMENTATION

\$7.00
\$2.00

FEB 14 1997

COMMISSION

LAND CORNER RECORDATION CERTIFICATE
Filing Requirement of Act 74, Mich. P.A. 1970
KENT COUNTY REMONUMENTATION

For corners in

Kent
(County)

Located in: Caledonia Township


Corner Code #

- | | | | |
|------------------------------------|-------------|--------------|------------|
| 1. Public Land Survey | T <u>5N</u> | R <u>10W</u> | <u>B-3</u> |
| | T _____ | R _____ | _____ |
| | T _____ | R _____ | _____ |
| | T _____ | R _____ | _____ |
| 2. Property Controlling in Section | S _____ | T _____ | R _____ |
| | S _____ | T _____ | R _____ |
| 3. Miscellaneous Property in Sec. | S _____ | T _____ | R _____ |
| | S _____ | T _____ | R _____ |

STATE OF MICHIGAN
COUNTY OF KENT
RECEIVED FOR RECORD
96 NOV -8 AM 9:16
9444
Register of Deeds Stamp & File Number

4. Lot No. _____, Recorded Plat _____
5. Private Claims _____

I, Randy Kolehouse, in a field survey on April 9 19 96, do hereby certify that under requirements of P.A. 74 Michigan P.A. of 1970, the corner points mentioned in lines 1 and 2 above were in conformance with regulations and rules therefore as required in the current manual of survey instructions of the United States Department of the interior, Bureau of Land Management or by a decree of a Court of Law and/or that the corner points mentioned in lines 3, 4 and 5 above were in conformance with the rules of the Michigan Board of Land Surveyors or by a Decree of a Court of Law; established, re-established, monumented, re-monumented, recovered, found as expressed below:

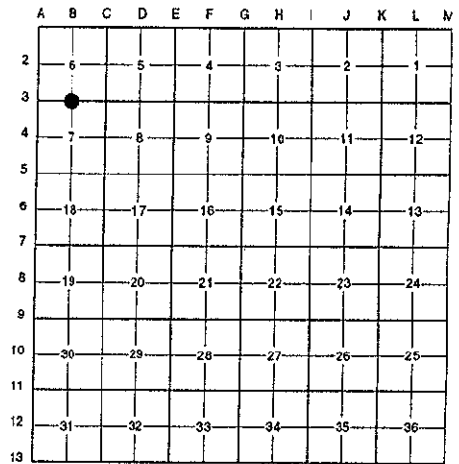

NOTE: Not more than 4 corners, all in the same town and range, may be recorded on this certificate.

A. Description of original monument and accessories and/or subsequent restoration:

B-3	1831	G.L.O. Notes	Mullet	Set Post
	1960	Witness Map	K.C. Surveyor	"X" in Pavement
	1973	L.C.R.C. #513	Exxel Engineering	Monument Box
	1981	L.C.R.C. #2525	J. Bueche	Fnd. Iron & Rod / Set K.C. Monument in Mon. Box
	1991	L.C.R.C. #5933	William Byl	K.C. Monument in Mon. Box

This corner was originally approved by the Kent County Remonumentation Peer Group and monumented by J. Bueche on 12/16/81 and was recorded per L.C.R.C. #2525.

B. Description of corner evidence found and/or method applied in restoring or reestablishing corner:

B-3 Found a Standard Kent County Monument in the C/L of 68th Street (bit.) running East and West on line of fence and tree row running South per L.C.R.C.'s #2525 and #5933 as set by J. Bueche in place of a 3/4" x 18" iron and a 12" square pointed rod he found in a monument box which checked L.C.R.C. #513.

L.C.R.C. #2525

L.C.R.C. #5933

"X" cut in North end conc. culvt. N 20° E 23.82'
"X" cut in South end conc. culvt. S 15° E 23.34'
PK nail in South side Power pole N 80° W 154.20'
PK nail in South side Power pole N 80° E 119.15'
on fence & tree row N & S
on C/L blktp. E & W


"X" cut N. end conc. culv. N 20° E 23.82' (m. 23.87)
"X" cut S. end conc. culv. S 15° E 23.34' (m. 23.39)
KC Remon. tag & nail S. side P. Pole N 80° W 154.14'
KC Remon. tag & nail S. side P. Pole N 80° E 119.15'

The selected location is accepted by me and is generally accepted by professional surveyors as the best available evidence of the position of the original corner.

C. Description of monument for corner and accessories established to perpetuate locating the position of the corner:

B-3 Standard Kent County Monument

"X" cut N. end conc. culv. N 20° E 23.87'
"X" cut S. end conc. culv. S 15° E 23.39'
Nail & K.C. remon. tag on S. side P. Pole N 80° W 154.14'
Nail & K.C. remon. tag on S. side P. pole N 80° E 119.15'

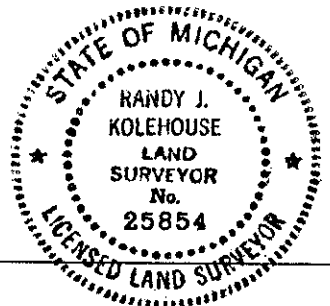

Signed by Randy J. Kolehouse
EARTH TECH

Date 10/8/96

Surveyor's Michigan License No. 25854

P.A. 345 1900 KENT COUNTY
PEER APPROVED 7/25/96
CHAIRMAN Harold M. ...