

\$7.00  
\$2.00

FEB 14 1997

LAND CORNER RECORDATION CERTIFICATE  
Filing Requirement of Act 74, Mich. P.A. 1970  
KENT COUNTY REMONUMENTATION

For corners in

COMMISSION

Kent (County)	Located in: Caledonia Township	Corner Code #
1. Public Land Survey	T <u>5N</u> R <u>10W</u>	<u>B-11</u>
	T _____ R _____	_____
	T _____ R _____	_____
	T _____ R _____	_____
2. Property Controlling in Section	S _____ T _____ R _____	_____
	S _____ T _____ R _____	_____
3. Miscellaneous Property in Sec.	S _____ T _____ R _____	_____
	S _____ T _____ R _____	_____


STATE OF MICHIGAN  
COUNTY OF KENT  
RECEIVED FOR RECORD

96 NOV -8 AM 9:16

REG. OF DEEDS  
*Randy Kolehose*  
9451

Register of Deeds Stamp & File Number

- 4. Lot No. \_\_\_\_\_, Recorded Plat \_\_\_\_\_
- 5. Private Claims \_\_\_\_\_

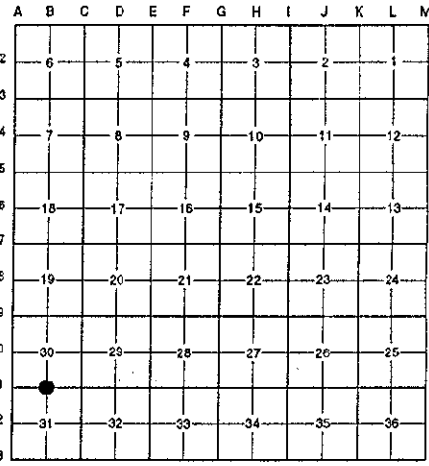

I, Randy Kolehose, in a field survey on April 10 19 96, do hereby certify that under requirements of P.A. 74 Michigan P.A. of 1970, the corner points mentioned in lines 1 and 2 above were in conformance with regulations and rules therefore as required in the current manual of survey instructions of the United States Department of the interior, Bureau of Land Management or by a decree of a Court of Law and/or that the corner points mentioned in lines 3, 4 and 5 above were in conformance with the rules of the Michigan Board of Land Surveyors or by a Decree of a Court of Law; established, re-established, monumented, re-monumented, recovered, found as expressed below:

NOTE: Not more than 4 corners, all in the same town and range, may be recorded on this certificate.

A. Description of original monument and accessories and/or subsequent restoration:

B-11 1831	G.L.O. Notes	Mullett	Set Post
1952	Witness Map	K.C. Surveyor	Iron in Monument Box
1974	L.C.R.C. #639	Exxel Engineering	Iron in Monument Box
1981	L.C.R.C. #2529	J. Bueche	Fnd. Iron in Mon. Box / Set K.C. Monument
1991	L.C.R.C. #5937	William Byl	K.C. Monument

This corner was originally approved by the Kent County Remonumentation Peer Group and monumented by J. Bueche on 12/22/81 and was recorded per L.C.R.C. #2529.

B. Description of corner evidence found and/or method applied in restoring or reestablishing corner:

B-11 Found a Standard Kent County Monument in a monument box in the C/L of 100th Street (bit.) running East and West per L.C.R.C.'s #2529 and #5937 as set by J. Bueche in place of a 1" x 17" iron he found in a monument box which checked L.C.R.C. #639 and the K.C. Surveyor's records.

L.C.R.C. #2529

L.C.R.C. #5937

K. C. Remon. tag & nail in NW side Power pole N 45° E 69.51'

KC Remo. tag & nail NW side P. Pole N 45° E 69.41'

KC Remon. tag & nail S. side P. Pole N 70° W 194.60'


P.A. 345 1990 KENT COUNTY  
PEER APPROVED 7/25/96  
CHAIRMAN *Randy Kolehose*

The selected location is accepted by me and is generally accepted by professional surveyors as the best available evidence of the position of the original corner.

C. Description of monument for corner and accessories established to perpetuate locating the position of the corner:

B-11 Standard Kent County Monument in a Monument Box

- Nail & K.C. remon. tag on NW side P. pole N 45° E 69.40'
- Nail & K.C. remon. tag on S side P. pole N 85° E 273.80'
- Nail & K.C. remon. tag on S side P. pole N 70° W 194.70'
- NE cor. house foundation S 85° W 282.13'

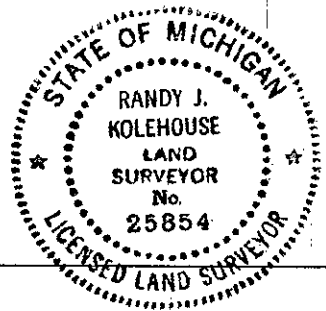

Signed by *Randy J. Kolehose*  
EARTH TECH

Date 10/8/96

Surveyor's Michigan License No. 25854