

\$7.00 REMONUMENTATION
\$2.00

FEB 14 1997

LAND CORNER RECORDATION CERTIFICATE
Filing Requirement of Act 74, Mich. P.A. 1970
KENT COUNTY REMONUMENTATION

For corners in

COMMISSION

Kent (County)	Located in: Caledonia Township	Corner Code #
1. Public Land Survey	T <u>5N</u> R <u>10W</u>	<u>B-12</u>
	T _____ R _____	_____
	T _____ R _____	_____
	T _____ R _____	_____
2. Property Controlling in Section	S _____ T _____ R _____	_____
	S _____ T _____ R _____	_____
3. Miscellaneous Property in Sec.	S _____ T _____ R _____	_____
	S _____ T _____ R _____	_____

STATE OF MICHIGAN
COUNTY OF KENT
RECEIVED FOR RECORD

96 NOV -8 AM 9:17


REG. OF DEEDS
Eric J. Land

9452

Register of Deeds Stamp & File Number

4. Lot No. _____, Recorded Plat _____
5. Private Claims _____

I, Randy Kolehouse, in a field survey on April 29 19 96, do hereby certify that under requirements of P.A. 74 Michigan P.A. of 1970, the corner points mentioned in lines 1 and 2 above were in conformance with regulations and rules therefore as required in the current manual of survey instructions of the United States Department of the interior, Bureau of Land Management or by a decree of a Court of Law and/or that the corner points mentioned in lines 3, 4 and 5 above were in conformance with the rules of the Michigan Board of Land Surveyors or by a Decree of a Court of Law; established, re-established, monumented, re-monumented, recovered, found as expressed below:

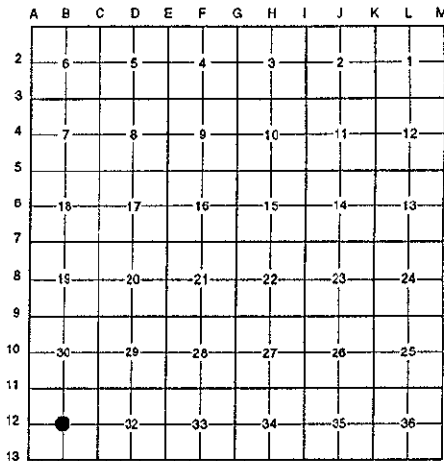

NOTE: Not more than 4 corners, all in the same town and range, may be recorded on this certificate.

A. Description of original monument and accessories and/or subsequent restoration:

B-12 This corner was not originally set by the G.L.O.

1982 L.C.R.C. #2932 Exxel Engineering 3/4" x 3' Rerod

B. Description of corner evidence found and/or method applied in restoring or reestablishing corner:

B-12 Found a 3/4" pipe per L.C.R.C. #2932. Pipe is 0.2' East and 0.1' South of the intersection of 1/4 lines. Accepted pipe as the Center of Section.

L.C.R.C. #2032

Nail in NE side P. Pole NW 7.07'
Nail in NW side 12" Elm SW 666.28'


P.A. 315 1800 KENT COUNTY
PEER APPROVED 9/22/96
CHAIRMAN *Randy Kolehouse*

The selected location is accepted by me and is generally accepted by professional surveyors as the best available evidence of the position of the original corner.

C. Description of monument for corner and accessories established to perpetuate locating the position of the corner:

B-12 Replaced 3/4" Pipe with a Standard Kent County Monument

Nail & K.C. remon. tag on NE side P. pole N 48° W 7.07'
Nail & K.C. remon. tag on NW side 16" Elm S 43° W 66.28'
Nail & K.C. remon. tag on NW side 14" Elm S 17° W 80.42'
Nail & K.C. remon. tag on W side 8" Elm S 05° W 71.25'

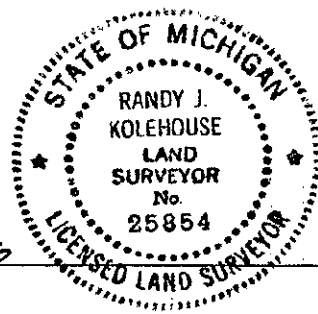

Signed by Randy Kolehouse
EARTH TECH

Date 10/8/96

Surveyor's Michigan License No. 25854