

**SURVEY &  
REMONUMENTATION**

FEB 14 1997

KENT COUNTY REMONUMENTATION

**COMMISSION LAND CORNER RECORDATION CERTIFICATE**  
Filing Requirement of Act 74, Mich. P.A. 1970

For corners in  
**KENT COUNTY**  
(County)

| Located In:       | Corner Code # |
|-------------------|---------------|
| T 5N R 10W        | C-1           |
| T ___ R ___       | _____         |
| T ___ R ___       | _____         |
| T ___ R ___       | _____         |
| T ___ R ___       | _____         |
| S ___ T ___ R ___ | _____         |
| S ___ T ___ R ___ | _____         |
| S ___ T ___ R ___ | _____         |
| S ___ T ___ R ___ | _____         |

REG. OF DEEDS

*Lucy St. Paul*

96 MAR 20 AM 8:48

STATE OF MICHIGAN  
COUNTY OF KENT  
RECEIVED FOR RECORD

**9011**

Register of Deeds Stamp & File Number

4. Lot No. \_\_\_\_\_, Recorded Plat \_\_\_\_\_  
5. Private Claims \_\_\_\_\_

I, Kirk Breitels, in a field survey on Feb. 14, 1996 do hereby state that under requirements of P.A. 74, Michigan P.A. of 1970, the corner points mentioned in lines 1 and 2 above were in conformance with regulations and rules therefore as required in the current manual of survey instructions of the United States Department of the Interior, Bureau of Land Management or by a decree of a Court of Law and/or that the corner points mentioned in lines 3, 4 and 5 above were in conformance with the rules of the Michigan Board of Land Surveyors or by a Decree of a Court of Law; established, re-established, monumented, recovered, found as expressed below:

NOTE: Not more than 2 corners, all in the same town and range, may be recorded on this certificate.

|    | A  | B | C  | D  | E  | F  | G  | H | I | J | K | L | M |
|----|----|---|----|----|----|----|----|---|---|---|---|---|---|
| 1  |    |   | ●  |    |    |    |    |   |   |   |   |   |   |
| 2  | 6  |   | 5  | 4  | 3  | 2  | 1  |   |   |   |   |   |   |
| 3  |    |   |    |    |    |    |    |   |   |   |   |   |   |
| 4  | 7  |   | 8  | 9  | 10 | 11 | 12 |   |   |   |   |   |   |
| 5  |    |   |    |    |    |    |    |   |   |   |   |   |   |
| 6  | 18 |   | 17 | 16 | 15 | 14 | 13 |   |   |   |   |   |   |
| 7  |    |   |    |    |    |    |    |   |   |   |   |   |   |
| 8  | 19 |   | 20 | 21 | 22 | 23 | 24 |   |   |   |   |   |   |
| 9  |    |   |    |    |    |    |    |   |   |   |   |   |   |
| 10 | 30 |   | 29 | 28 | 27 | 26 | 25 |   |   |   |   |   |   |
| 11 |    |   |    |    |    |    |    |   |   |   |   |   |   |
| 12 | 31 |   | 32 | 33 | 34 | 35 | 36 |   |   |   |   |   |   |
| 13 |    |   |    |    |    |    |    |   |   |   |   |   |   |

P.A. 345 1990 KENT COUNTY

PEER APPROVED 3/7/96  
CHAIRMAN *Harry Stuber*

A. Description of original monument and accessories and/or subsequent restoration:

|     |         |                  |              |                                |
|-----|---------|------------------|--------------|--------------------------------|
| C-1 | 1830    | GLO              | Mullett      | Set Post                       |
|     | 1950-65 | Williams & Works |              | Mon. Box. (12.4' West of C-13) |
|     | 1966    | Kent Co. Wit.    |              | Mon. Box                       |
|     | 1972    | LCRC #213        | Bonnema      | 1/2" Iron in Mon. Box          |
|     | 1985    | LCRC #4157       | Chettleburgh | Set Kent County Monument       |
|     | 1994    | LCRC #7076       | Bueche       | Kent County Monument           |

The position of this corner was previously approved by the Kent County Remonumentation Peer Group, monumented by Thomas Chettleburgh on 4/3/85 and was recorded per LCRC #4157

B. Description of corner evidence found and/or method applied in restoring or reestablishing corner:

C-1 Found standard Kent Co. Mon. (Harrison) per witnesses from above LCRC as set by Thomas Chettleburgh on Twp. Line 12.40' West of C-13, T6N, R10W. Said locatio checks with Williams & Works information. LCRC #213 is for incorrect corner.

LCRC #4157 (Nail/tag in trees-poles)      LCRC #7076 (Nail/tag in trees-poles)


|                                   |                                  |
|-----------------------------------|----------------------------------|
| PP S58°E 125.38' TP N05°W 177.67' | PP S25°W 77.10' TP N05°W 177.67' |
| 12" Maple N31°E 84.14'            | 14" Maple N31°E 84.14'           |
| 26" Willow N65°W 110.82'          | "X" top culv. N43°W 47.37'       |
| "X" on culv. N43°W 47.37'         | C/L end culv. N50°E 46.62'       |
| "X" on culv. N50°E 46.62'         | C-13, 6-10 East 12.40'           |

The selected location is accepted by me and is generally accepted by professional surveyors as the best available evidence of the position of the original corner.

C. Description of monument for corner and accessories established to perpetuate locating the position of the corner:

C-1 Standard Kent County Monument

|                                      |       |         |
|--------------------------------------|-------|---------|
| Nail & MDSH tag NW side 16" Maple    | N31°E | 84.24'  |
| C/L E. end 36" culvert               | N50°E | 46.62'  |
| "X" cut to W. end 36" culvert        | N43°W | 47.37'  |
| Nail & KC Remon. tag E. side P. Pole | S25°W | 77.14'  |
| Nail & KC Remon. tag E. side T. Pole | N05°W | 177.70' |
| Kent Co. Mon. (C-13, T6N, R10W)      | East  | 12.40'  |
| Iron in Mon. Box                     | West  | 11.94'  |

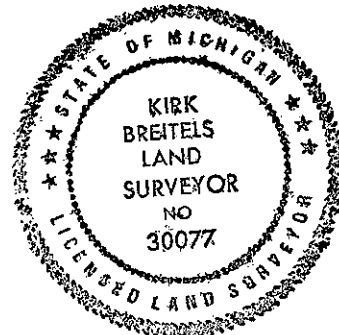

Signed by *Kirk Breitels*

Date 3/1/96

Surveyor's Michigan License No. 30077