

SURVEY & REMONUMENTATION

\$7.00
\$2.00

FEB 14 1997

COMMISSION

LAND CORNER RECORDATION CERTIFICATE
Filing Requirement of Act 74, Mich. P.A. 1970
KENT COUNTY REMONUMENTATION

For corners in


Kent (County)	Located in: Caledonia Township	Corner Code #
1. Public Land Survey	T <u>5N</u> R <u>10W</u>	<u>C-2</u>
	T _____ R _____	_____
	T _____ R _____	_____
	T _____ R _____	_____
2. Property Controlling in Section	S _____ T _____ R _____	_____
	S _____ T _____ R _____	_____
3. Miscellaneous Property in Sec.	S _____ T _____ R _____	_____
	S _____ T _____ R _____	_____

STATE OF MICHIGAN
 COUNTY OF KENT
 RECEIVED FOR RECORD
 96 NOV -8 AM 9:17
 REG. OF DEEDS
[Signature]

9455

Register of Deeds Stamp & File Number

4. Lot No. _____, Recorded Plat _____
 5. Private Claims _____

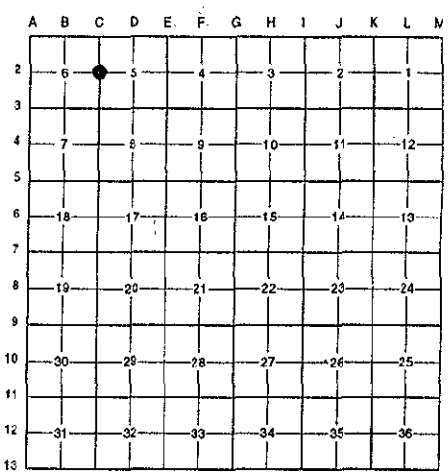

I, Randy Kolehouse, in a field survey on April 9 19 96, do hereby certify that under requirements of P.A. 74 Michigan P.A. of 1970, the corner points mentioned in lines 1 and 2 above were in conformance with regulations and rules therefore as required in the current manual of survey instructions of the United States Department of the interior, Bureau of Land Management or by a decree of a Court of Law and/or that the corner points mentioned in lines 3, 4 and 5 above were in conformance with the rules of the Michigan Board of Land Surveyors or by a Decree of a Court of Law; established, re-established, monumented, re-monumented, recovered, found as expressed below:

NOTE: Not more than 4 corners, all in the same town and range, may be recorded on this certificate.

A. Description of original monument and accessories and/or subsequent restoration:

C-2	1831	G.L.O. Notes	Mullett	Set Post
	1963	Witness Map	K.C. Surveyor	Monument Box
	1974	L.C.R.C. #769	G. Nederveld	Bt. Spike in Mon. Box
	1981	L.C.R.C. #2530	J. Bueche	Fnd. Bt. Spike in Mon. Box / Set K.C. Monument in Mon. Box
	1987	L.C.R.C. #4556	Prein & Newhof	K.C. Monument in Mon. Box
	1991	L.C.R.C. #5939	William Byl	K.C. Monument in Mon. Box

P.A. 345 1990 KENT COUNTY
 PEER APPROVED 7/25/96
 CHAIRMAN [Signature]

This corner was originally approved by the Kent County Remonumentation Peer Group and monumented by J. Bueche on 12/16/81 and was recorded per L.C.R.C. #2530.

B. Description of corner evidence found and/or method applied in restoring or reestablishing corner:

C-2 Found a Standard Kent County Monument 1.5' West of the C/L of Kraft Avenue (bt.) running North and South per L.C.R.C.'s #2530, #4556 and #5939 as set by J. Bueche in place of a boat spike in a 1" x 24" iron in a monument box over a 2" x 12" wooden hub, on top of stones, which checked L.C.R.C. #769 and the K.C. Surveyor's records.

L.C.R.C. #2530

L.C.R.C. #5939

K.C. Remon. tag & nail in NE side Power pole #575 N 40° W 71.88'
 Sq. spk. in West side 12" Oak S 20° E 109.44'
 On C/L blktp. N & S
 Power line West in North 50' M/L


Nail & KC Remon. tag NE side P. Pole N 40° W 71.81'
 Nail & KC Remon. tag S. side Tri. 10" Ash N 90° E 76.97' (m. 76.95')
 Nail & KC Remon. tag W. side 14" Oak S 20° E 109.43'
 Steel bar & cap (EXXEL)

The selected location is accepted by me and is generally accepted by professional surveyors as the best available evidence of the position of the original corner.

C. Description of monument for corner and accessories established to perpetuate locating the position of the corner:

C-2 Standard Kent County Monument

- Nail & K.C. remon. tag on E side 10" Oak S 45° W 70.34'
- Nail & K.C. remon. tag on NE side P. pole N 40° W 71.81'
- Nail & K.C. remon. tag on S side 10" Tri. Ash N 90° E 76.95'
- Nail & K.C. remon. tag on W side 14" Oak S 20° E 109.43'
- Capped rebar (Exxel) S 90° W 32.78'

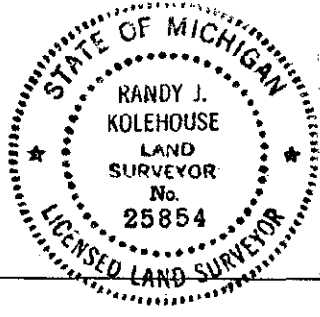

Signed by Randy J. Kolehouse
 EARTH TECH

Date 10/8/96

Surveyor's Michigan License No. 25854