

\$7.00 SURVEY & REMONUMENTATION
 \$2.00
 FEB 14 1997

LAND CORNER RECORDATION CERTIFICATE
 Filing Requirement of Act 74, Mich. P.A. 1970
 KENT COUNTY REMONUMENTATION

For corners in **COMMISSION**

Kent (County)	Located in:	Caledonia Township	Corner Code #
1. Public Land Survey	T <u>5N</u>	R <u>10W</u>	<u>C-3</u>
	T _____	R _____	_____
	T _____	R _____	_____
	T _____	R _____	_____
2. Property Controlling in Section	S _____	T _____	R _____
	S _____	T _____	R _____
3. Miscellaneous Property in Sec.	S _____	T _____	R _____
	S _____	T _____	R _____

STATE OF MICHIGAN
 COUNTY OF KENT
 RECEIVED FOR RECORD

96 NOV -8 AM 9:17

REG. OF DEEDS


Randy Kolehose

9456

Register of Deeds Stamp & File Number

4. Lot No. _____, Recorded Plat _____
 5. Private Claims _____

I, Randy Kolehose, in a field survey on April 3 19 96, do hereby certify that under requirements of P.A. 74 Michigan P.A. of 1970, the corner points mentioned in lines 1 and 2 above were in conformance with regulations and rules therefore as required in the current manual of survey instructions of the United States Department of the interior, Bureau of Land Management or by a decree of a Court of Law and/or that the corner points mentioned in lines 3, 4 and 5 above were in conformance with the rules of the Michigan Board of Land Surveyors or by a Decree of a Court of Law; established, re-established, monumented, re-monumented, recovered, found as expressed below:

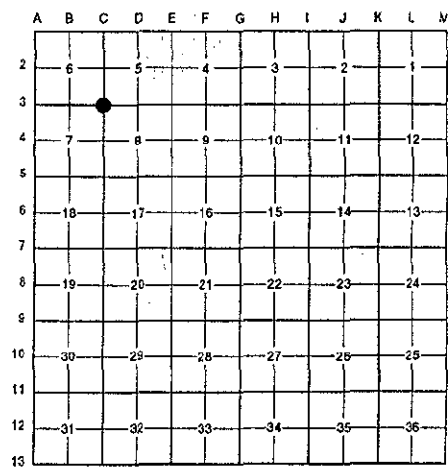

NOTE: Not more than 4 corners, all in the same town and range, may be recorded on this certificate.

A. Description of original monument and accessories and/or subsequent restoration:

C-3	1831	G.L.O. Notes	Mullett	Set Post
	1960	Witness Map	K.C. Surveyor	"X" on C/L "X" Conc. Rds.
	1973	L.C.R.C. #513	Exxel Engineering	3/4" Iron in Mon. Box
	1981	L.C.R.C. #2531	J. Bueche	Fnd. 3/4" x 18" Iron, 10" Sq. Spike & 1-1/4 x 24" Iron in Mon. Box / Set K.C. Monument
	1991	L.C.R.C. #5940	William Byl	K.C. Monument

This corner was originally approved by the Kent County Remonumentation Peer Group and monumented by J. Bueche on 12/16/81 and was recorded per L.C.R.C. #2531.

B. Description of corner evidence found and/or method applied in restoring or reestablishing corner:

C-3 Found a Standard Kent County Monument in the C/L intersection of Kraft Avenue (bit.) running North and South and 68th Street (bit.) running East and West per L.C.R.C.'s #2531 and #5940 as set by J. Bueche in place of a 3/4" x 18" iron, 10" sq. spike and a 1-1/4 x 24" iron he found in a monument box which checked L.C.R.C. #513 and the K.C. Surveyor's records.

L.C.R.C. #2531

K. C. Remon. tag & nail in NE side Power pole N 35° W 37.52'
 SW'y cor. of store N 35° E 71.35'
 SE'y cor. of store N 60° E 74.08'
 W'y cor. C.B. grate at back of curb S 50° W 36.27'

L.C.R.C. #5940


KC Remon. tag & nail NE side P. Pole N 35° W 37.52'
 SW'y cor. of store (siding) N 35° E 71.43' (m. 71.49')
 SE'y cor. of store (siding) N 60° E 74.08' (74.09')
 W'y cor. C.B. grate at back of curb S 50° W 36.22' (m. 36.18')
 C/L MBT Manhole S 35° E 61.77'

The selected location is accepted by me and is generally accepted by professional surveyors as the best available evidence of the position of the original corner.

C. Description of monument for corner and accessories established to perpetuate locating the position of the corner:

C-3 Standard Kent County Monument

Nail & K.C. remon. tag on NE side P. pole N 35° W 37.52'
 SW'y cor. of store (siding) N 35° E 71.49'
 SE'y cor. of store (siding) N 60° E 74.09'
 N'y cor. C.B. grate at B.C. S 50° W 36.18'
 C/L MBT manhole S 35° E 61.77'

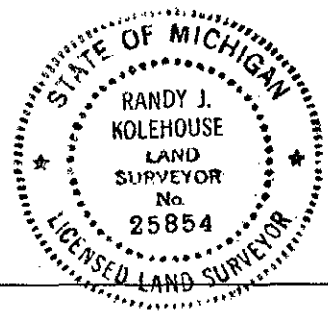

Signed by Randy J. Kolehose Date 10/2/96
 EARTH TECH

Surveyor's Michigan License No. 25854
 P.A. 345 1990 KENT COUNTY

PEER APPROVED 7/25/96
 CHAIRMAN Harold Kulehose