

SURVEY &
 REMONUMENTATION
 \$7.00
 \$2.00

FEB 14 1997

LAND CORNER RECORDATION CERTIFICATE
Filing Requirement of Act 74, Mich. P.A. 1970
KENT COUNTY REMONUMENTATION

For corners in


Kent (County)	Located in: Caledonia Township	Corner Code #
1. Public Land Survey	T <u>5N</u> R <u>10W</u>	<u>C-5</u>
	T _____ R _____	_____
	T _____ R _____	_____
	T _____ R _____	_____
2. Property Controlling in Section	S _____ T _____ R _____	_____
	S _____ T _____ R _____	_____
3. Miscellaneous Property in Sec.	S _____ T _____ R _____	_____
	S _____ T _____ R _____	_____

STATE OF MICHIGAN
 COUNTY OF KENT
 RECEIVED FOR RECORD
 96 NOV -8 AM 9:17
 REG. OF DEEDS
Lucy Bond

9458
 Register of Deeds Stamp & File Number

4. Lot No. _____, Recorded Plat _____
 5. Private Claims _____

I, Randy Kolehouse, in a field survey on April 3 19 96, do hereby certify that under requirements of P.A. 74 Michigan P.A. of 1970, the corner points mentioned in lines 1 and 2 above were in conformance with regulations and rules therefore as required in the current manual of survey instructions of the United States Department of the interior, Bureau of Land Management or by a decree of a Court of Law and/or that the corner points mentioned in lines 3, 4 and 5 above were in conformance with the rules of the Michigan Board of Land Surveyors or by a Decree of a Court of Law; established, re-established, monumented, re-monumented, recovered, found as expressed below:

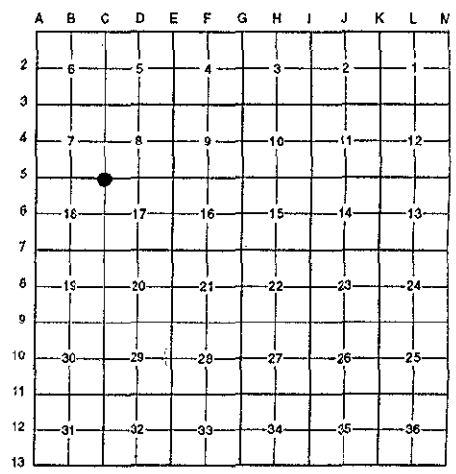

NOTE: Not more than 4 corners, all in the same town and range, may be recorded on this certificate.

A. Description of original monument and accessories and/or subsequent restoration:

C-5	1831	G.L.O. Notes	Mullet	Set Post
	1965	Witness Map	K.C. Surveyor	Monument Box
	1972	L.C.R.C. #234	F. Spicer	Spike
	19xx	L.C.R.C. #957	P. McPherson	1/2" Pipe in Mon. Box
	1981	L.C.R.C. #2533	J. Bueche	Fnd. 3/4" Iron in Mon. Box / Set K.C. Monument in Mon. Box
	1991	L.C.R.C. #5942	William Byl	K.C. Monument in Mon. Box

This corner was originally approved by the Kent County Remonumentation Peer Group and monumented by J. Bueche on 12/17/81 and was recorded per L.C.R.C. #2533.

B. Description of corner evidence found and/or method applied in restoring or reestablishing corner:

C-5 Found a Standard Kent County Monument in a monument box in the C/L intersection of Kraft Avenue (bit.) running North and South and 76th Street (bit.) running East and West per L.C.R.C.'s #2533 and #5942 as set by J. Bueche in place of a 3/4" x 18" iron he found in a monument box which checked L.C.R.C.'s #957, #234 and the K.C. Surveyor's records.

L.C.R.C. #2533

L.C.R.C. #5942

- K. C. Remon. tag & nail in West side 38" Oak S 20° W 116.00'
- K. C. Remon. tag & nail in West side Power pole S 15° E 87.28'
- "X" cut in South end conc. culvt. S 75° E 74.43'
- "X" cut in North end conc. culvt. N 70° E 72.63'
- "X" cut in conc. curb N 45° W 36.43'
- On C/L "X"

- KC Remon. tag & nail W. side 42" Oak (stump) S 20° W 115.95' (m. 115.88')
- KC Remon. tag & nail W. side P. Pole S 15° E 87.26' (m. 87.38')
- "X" cut S. end conc. culv. S 75° E 74.40' (m. 74.45')
- "X" cut N. end conc. culv. N 70° E 72.58' (m. 72.61')
- "X" cut in conc. curb N 45° W 36.43' (m. 36.47')

The selected location is accepted by me and is generally accepted by professional surveyors as the best available evidence of the position of the original corner.


C. Description of monument for corner and accessories established to perpetuate locating the position of the corner:

C-5 Standard Kent County Monument in a Monument Box

- Nail & K.C. remon. tag on W side 42" Oak S 20° W 115.88'
- Nail & K.C. remon. tag on W side P. pole S 15° E 87.38'
- "X" cut in s end culv. S 75° E 74.45'
- "X" cut in N end culv. N 70° E 72.61'
- "X" cut in conc. curb N 45° W 36.47'
- Nail & K.C. remon. tag on NW side L. pole S 50° W 42.85'

Signed by *Randy J. Kolehouse* Date 10/3/96

Surveyor's Michigan License No. 25854

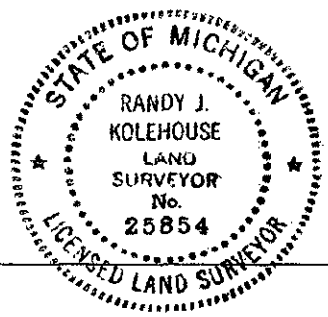

P.A. 345 1990 KENT COUNTY
 PEER APPROVED 7/25/96
 CHAIRMAN *James Hubert*