

**SURVEY & REMONUMENTATION**

\$7.00  
\$2.00

FEB 14 1997

COMMISSION

**LAND CORNER RECORDATION CERTIFICATE**  
Filing Requirement of Act 74, Mich. P.A. 1970  
KENT COUNTY REMONUMENTATION

For corners in

Kent (County)	Located in: Caledonia Township	Corner Code #
1. Public Land Survey	T <u>5N</u> R <u>10W</u>	<u>C-7</u>
	T _____ R _____	_____
	T _____ R _____	_____
	T _____ R _____	_____
2. Property Controlling in Section	S _____ T _____ R _____	_____
	S _____ T _____ R _____	_____
3. Miscellaneous Property in Sec.	S _____ T _____ R _____	_____
	S _____ T _____ R _____	_____


STATE OF MICHIGAN  
COUNTY OF KENT  
RECEIVED FOR RECORD  
96 NOV -8 AM 9:17  
REG. OF DEEDS  
*Lucy Bond*

9460

Register of Deeds Stamp & File Number

4. Lot No. \_\_\_\_\_, Recorded Plat \_\_\_\_\_  
5. Private Claims \_\_\_\_\_

I, Randy Kolehouse, in a field survey on April 3 19 96, do hereby certify that under requirements of P.A. 74 Michigan P.A. of 1970, the corner points mentioned in lines 1 and 2 above were in conformance with regulations and rules therefore as required in the current manual of survey instructions of the United States Department of the interior, Bureau of Land Management or by a decree of a Court of Law and/or that the corner points mentioned in lines 3, 4 and 5 above were in conformance with the rules of the Michigan Board of Land Surveyors or by a Decree of a Court of Law; established, re-established, monumented, re-monumented, recovered, found as expressed below:

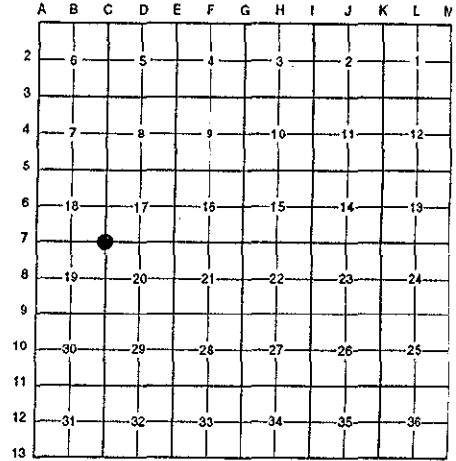

**NOTE: Not more than 4 corners, all in the same town and range, may be recorded on this certificate.**

**A. Description of original monument and accessories and/or subsequent restoration:**

C-7	1831	G.L.O. Notes	Mullett	Set Post
	1963	Witness Map	K.C. Surveyor	Iron in Monument Box
	19xx	L.C.R.C. #957	P. McPherson	3/4" Pipe in Mon. Box
	1981	L.C.R.C. #2535	J. Bueche	Fnd. 3/4" Iron in Mon. Box / Set K.C. Monument in Mon. Box
	1991	L.C.R.C. #5944	William Byl	K.C. Monument in a Mon. Box

This corner was originally approved by the Kent County Remonumentation Peer Group and monumented by J. Bueche on 12/17/81 and was recorded per L.C.R.C. #2535.

**B. Description of corner evidence found and/or method applied in restoring or reestablishing corner:**

C-7 Found a Standard Kent County Monument in a monument box 1' East of the C/L of Kraft Avenue (bit.) running North and South and on the C/L of 84th Street (bit.) running East and West per L.C.R.C.'s #2535 and #5944 as set by J. Bueche in place of a 3/4" pipe he found in a monument box which checked L.C.R.C. #957 and the K.C. Surveyor's records.

L.C.R.C. #2535

L.C.R.C. #5944

"X" cut in conc. curb N 45° W 36.44'  
NE cor. brick garage S 65° W 133.15'  
SE cor. brick garage N 60° E 142.46'  
On C/L "X"


"X" cut in conc. curb N 45° W 36.47' (m. 36.54')  
NE cor. brick garage S 65° W 133.04'  
SE cor. brick garage N 60° E 142.46'  
NW cor. brick bell tower S 35° E 128.10'  
Nail & KC Remon. tag NE side P. Pole N 50° W 60.59'

The selected location is accepted by me and is generally accepted by professional surveyors as the best available evidence of the position of the original corner.

**C. Description of monument for corner and accessories established to perpetuate locating the position of the corner:**

-C-7 Standard Kent County Monument in a Monument Box

"X" cut in conc. curb N 45° W 36.54'  
NE cor. brick garage S 65° W 133.04'  
SE cor. brick garage N 60° E 142.46'  
NW cor. brick bell tower S 35° E 128.10'  
Nail & K.C. remon. tag on NE side P. pole N 50° W 60.59'

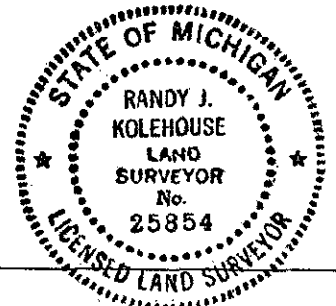

Signed by Randy J. Kolehouse  
EARTH TECH

Date 10/8/96

Surveyor's Michigan License No. 25854

P.A. 345 1990 KENT COUNTY

PEER APPROVED 7/25/96

CHAIRMAN [Signature]