

**SURVEY & REMONUMENTATION**

\$7.00  
\$2.00

FEB 14 1997

**LAND CORNER RECORDATION CERTIFICATE**  
Filing Requirement of Act 74, Mich. P.A. 1970  
KENT COUNTY REMONUMENTATION

COMMISSION

For corners in

Kent (County)	Located in: Caledonia Township	Corner Code #
1. Public Land Survey	T <u>5N</u> R <u>10W</u>	<u>C-9</u>
	T _____ R _____	_____
	T _____ R _____	_____
	T _____ R _____	_____
2. Property Controlling in Section	S _____ T _____ R _____	_____
	S _____ T _____ R _____	_____
3. Miscellaneous Property in Sec.	S _____ T _____ R _____	_____
	S _____ T _____ R _____	_____
4. Lot No. _____, Recorded Plat _____		
5. Private Claims _____		


STATE OF MICHIGAN  
COUNTY OF KENT  
RECEIVED FOR RECORD  
96 NOV -8 AM 9:18  
REG. OF DEEDS  
*David Sand*

9462

Register of Deeds Stamp & File Number

I, Randy Kolehouse, in a field survey on April 3 19 96, do hereby certify that under requirements of P.A. 74 Michigan P.A. of 1970, the corner points mentioned in lines 1 and 2 above were in conformance with regulations and rules therefore as required in the current manual of survey instructions of the United States Department of the interior, Bureau of Land Management or by a decree of a Court of Law and/or that the corner points mentioned in lines 3, 4 and 5 above were in conformance with the rules of the Michigan Board of Land Surveyors or by a Decree of a Court of Law; established, re-established, monumented, re-monumented, recovered, found as expressed below:

NOTE: Not more than 4 corners, all in the same town and range, may be recorded on this certificate.

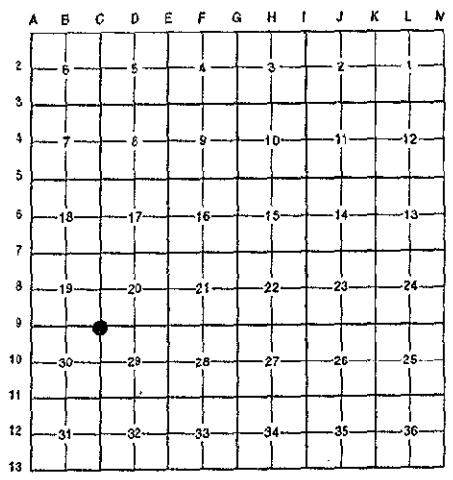

A. Description of original monument and accessories and/or subsequent restoration:

C-9	1831	G.L.O. Notes	Mullett	Set Post
	1964	Witness Map	K.C. Surveyor	Iron in Monument Box
	1972	L.C.R.C. #261	Medema, Van Kooten & Assoc.	Monument Box
	1981	L.C.R.C. #2056	Nederveld & Jonker	Fnd. 1" Iron in Mon. Box / Set K.C. Monument in a Mon. Box
	1991	L.C.R.C. #5946	William Byl	K.C. Monument in a Mon. Box

This corner was originally approved by the Kent County Remonumentation Peer Group and monumented by Nederveld & Jonker on 7/7/81 and was recorded per L.C.R.C. #2056.

B. Description of corner evidence found and/or method applied in restoring or reestablishing corner:

-9 Found a Standard Kent County Monument in a monument box in the C/L intersection of Kraft Avenue (bit.) running North and South and 92nd Street (bit.) running East and West per L.C.R.C.'s #2056 and #5946 as set by Nederveld & Jonker in place of 1" round iron they found in a monument box which checked L.C.R.C. #261 and the K.C. Surveyor's records.

L.C.R.C. #2056

L.C.R.C. #5946

Nail & K.C. Remon. tag NE side P. pole N 30° W 63.20'  
Nail & K.C. Remon. tag W side P. pole N 32° E 61.29'  
Nail & K.C. Remon. tag E side P. pole S 30° W 121.66'  
NW cor. hse. fnd. S 40° E 74.50'

Nail & KC Remon tag NE side P. Pole N 30° W 63.28' (m. 63.26')  
Nail & KC Remon tag W. side P. Pole N 32° E 61.35' (m. 61.32')  
Nail & KC Remon tag E. side P. Pole S 30° W 121.64'  
NW cor. hse. fnd. S 40° E 74.60' (m. 74.50')  
Nail & KC Remon. tag NW side Guy Pole S 55° W 59.64'

The selected location is accepted by me and is generally accepted by professional surveyors as the best available evidence of the position of the original corner.

- Description of monument for corner and accessories established to perpetuate locating the position of the corner:

-9 Standard Kent County Monument in a Monument Box

Nail & K.C. remon. tag on E side P. pole S 30° W 121.64'  
Nail & K.C. remon. tag on NW side Guy pole S 55° W 59.64'  
Nail & K.C. remon. tag on NE side P. pole N 30° W 63.26'  
Nail & K.C. remon. tag on N side P. pole N 32° E 61.32'  
NW cor. hse. fndn. S 55° W 74.50'



Signed by Randy J. Kolehouse  
EARTH TECH

Date 10/8/96

Surveyor's Michigan License No. 25854

P.A. 345 1990 KENT COUNTY

PEER APPROVED 7/25/96

CHAIRMAN Walter H. ...