

\$7.00
\$2.00

SURVEY & REMONUMENTATION

FEB 14 1997

COMMISSION

LAND CORNER RECORDATION CERTIFICATE Filing Requirement of Act 74, Mich. P.A. 1970 KENT COUNTY REMONUMENTATION

For corners in


Kent (County)	Located in: Caledonia Township	Corner Code #
1. Public Land Survey	T <u>5N</u> R <u>10W</u>	<u>C-12</u>
	T _____ R _____	_____
	T _____ R _____	_____
	T _____ R _____	_____
2. Property Controlling in Section	S _____ T _____ R _____	_____
	S _____ T _____ R _____	_____
3. Miscellaneous Property in Sec.	S _____ T _____ R _____	_____
	S _____ T _____ R _____	_____

STATE OF MICHIGAN
COUNTY OF KENT
RECEIVED FOR RECORD
95 NOV -8 AM 9:18
REG. OF DEEDS
Lucy Bond
9465
Register of Deeds Stamp & File Number

4. Lot No. _____, Recorded Plat _____
5. Private Claims _____

I, Randy Kolehouse, in a field survey on April 3 19 96, do hereby certify that under requirements of P.A. 74 Michigan P.A. of 1970, the corner points mentioned in lines 1 and 2 above were in conformance with regulations and rules therefore as required in the current manual of survey instructions of the United States Department of the interior, Bureau of Land Management or by a decree of a Court of Law and/or that the corner points mentioned in lines 3, 4 and 5 above were in conformance with the rules of the Michigan Board of Land Surveyors or by a Decree of a Court of Law; established, re-established, monumented, re-monumented, recovered, found as expressed below:

NOTE: Not more than 4 corners, all in the same town and range, may be recorded on this certificate.

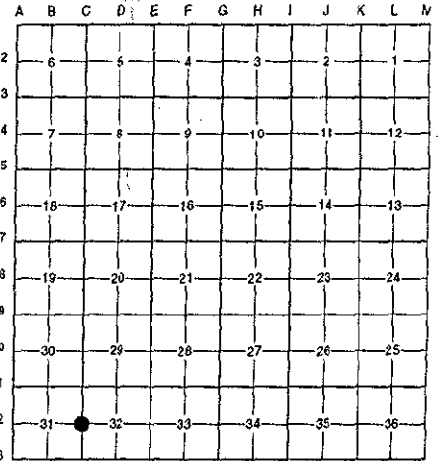

A. Description of original monument and accessories and/or subsequent restoration:

C-12	1831	G.L.O. Notes	Mullett	Set Post
	1972	L.C.R.C. #409	P. VanPoolen	Fence Post Set in Conc.
	1979	L.C.R.C. #1271	Exxel Engineering	Set Capped Rerod at Base of Steel Fence Post in Conc.
	1982	L.C.R.C. #2670	Jonker Land Surveys	Capped Iron Set in Concrete
	1991	L.C.R.C. #5949	William Byl	Steel Bar Set in Concrete

This corner was originally approved by the Kent County Remonumentation Peer Group and monumented by Jonker on 3/3/82 and was recorded per L.C.R.C. #2670.

B. Description of corner evidence found and/or method applied in restoring or reestablishing corner:

C-12 Found a capped rebar in concrete per L.C.R.C.'s #1271, #2670 and #5949 at a fence corner running North and East.

L.C.R.C. #1271

Fences N-S, E-W
PK in sde P. Pole West 47.74'
Nail in sde fence post North 41.77'

L.C.R.C. #5949

Nail & KC Remon. tag N. side P. Pole N 90° W 47.75' (m. 47.68')
Nail & KC Remon. tag W. side 6" Maple N 15° W 48.51' (m. 48.22')
Nail & KC Remon. tag NW side 10" Poplar S 25° W 73.67' (m. 73.86')
Nail & KC Remon. tag W. side 12" Maple S 00° W 97.31' (m. 97.48')
Nail & KC Remon. tag NE side 8" Poplar S 30° E 93.64' (m. 93.85')
At fence corner to N & E
On E-W power line m/l

The selected location is accepted by me and is generally accepted by professional surveyors as the best available evidence of the position of the original corner.

C. Description of monument for corner and accessories established to perpetuate locating the position of the corner:


C-12 Rebar in Concrete at Fence Corner

Nail & K.C. remon. tag on N side P. pole N 90° W 47.68'
Nail & K.C. remon. tag on W side 6" Maple N 15° W 48.22'
Nail & K.C. remon. tag on NW side 10" Poplar S 25° W 73.86'
Nail & K.C. remon. tag on W side 12" Maple S 00° W 97.48'
Nail & K.C. remon. tag on NE side 8" Poplar S 30° E 93.85'

Signed by *Randy J Kolehouse*
EARTH TECH

Date 10/8/96

Surveyor's Michigan License No. 25854

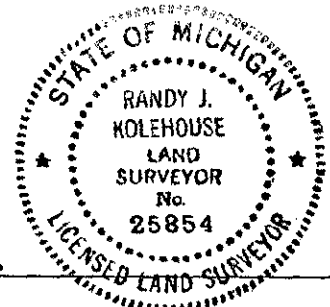

P.A. 345 1990 KENT COUNTY
PEER APPROVED 7/25/96
CHAIRMAN *[Signature]*