

**SURVEY &  
REMONUMENTATION**

**\$7.00  
\$2.00**

FEB 14 1997

COMMISSION

**LAND CORNER RECORDATION CERTIFICATE  
Filing Requirement of Act 74, Mich. P.A. 1970  
KENT COUNTY REMONUMENTATION**

For corners in

<u>Kent</u> (County)	Located in: Caledonia Township	Corner Code #
1. Public Land Survey	T <u>5N</u> R <u>10W</u>	<u>C-13</u>
	T _____ R _____	_____
	T _____ R _____	_____
	T _____ R _____	_____
2. Property Controlling in Section	S _____ T _____ R _____	_____
	S _____ T _____ R _____	_____
3. Miscellaneous	S _____ T _____ R _____	_____
Property in Sec.	S _____ T _____ R _____	_____

REG. OF DEEDS

*Randy J. Kolehhouse*

96 NOV -8 AM 9:18

STATE OF MICHIGAN  
COUNTY OF KENT  
RECEIVED FOR RECORD

**9466**

Register of Deeds Stamp & File Number

4. Lot No. \_\_\_\_\_, Recorded Plat \_\_\_\_\_  
5. Private Claims \_\_\_\_\_

I, Randy Kolehhouse, in a field survey on April 3 19 96, do hereby certify that under requirements of P.A. 74 Michigan P.A. of 1970, the corner points mentioned in lines 1 and 2 above were in conformance with regulations and rules therefore as required in the current manual of survey instructions of the United States Department of the interior, Bureau of Land Management or by a decree of a Court of Law and/or that the corner points mentioned in lines 3, 4 and 5 above were in conformance with the rules of the Michigan Board of Land Surveyors or by a Decree of a Court of Law; established, re-established, monumented, re-monumented, recovered, found as expressed below:

**NOTE: Not more than 4 corners, all in the same town and range, may be recorded on this certificate.**

**A. Description of original monument and accessories and/or subsequent restoration:**

C-13 1817	G.L.O. Notes	L. Lyon	Set Post
1937	Witness Map	K.C. Surveyor	Concrete Monument
1972	L.C.R.C. #409	P. VanPoolen	"T" Iron
1981	L.C.R.C. #1708	Williams & Works	Fnd. "T" Iron / Set K.C. Monument
1991	L.C.R.C. #5950	J. Bueche	K.C. Monument

Note: This corner is not common with C-1, T4N, R10W.

This corner was originally approved by the Kent County Remonumentation Peer Group and monumented by Williams & Works on 2/23/81 and was recorded per L.C.R.C. #1708.

**B. Description of corner evidence found and/or method applied in restoring or reestablishing corner:**

C-13 Found a Standard Kent County Monument 3' South of the C/L of 108th Street (gravel) running East and West on line of a fence and tree row running North per L.C.R.C.'s #1708 and #5950 as set by Williams & Works in place of a "T" iron along side of a 1/2" iron down 30" they found which checked L.C.R.C. #409 and the K.C. Surveyor's records.

**L.C.R.C. #1708**

Nail and K.C. Remon. Tag in N. Side 4" Twin Maple S 40° E 142.76'  
R.R. Spike in Blktp. N 80° E 6.0'  
C/L 108th St. (Blktp.) E & W North 2.0' ±  
Fence and Tree Line North

**L.C.R.C. #5950**

Nail & KC Remon. tag W. side 10" Triple Maple S 30° E 142.52' (m. 142.45')  
R.R. Spike in Blktp. N 80° E 6.05'  
Nail & KC Remon. tag NW cor. 6" Sq. wood post N 65° E 54.08' (m. 54.10')  
Steel bar & cap (MVK) N 00° E 33.02'

The selected location is accepted by me and is generally accepted by professional surveyors as the best available evidence of the position of the original corner.

**C. Description of monument for corner and accessories established to perpetuate locating the position of the corner:**


C-13 Standard Kent County Monument

Nail & K.C. remon. tag on W side 10" Trip. Maple S 30° E 142.45'  
R.R. spike in blacktop N 80° E 6.05'  
NW cor. wood 6" square post N 65° E 54.10'  
Capped rebar (MVK) N 00° E 33.02'  
Set Nail & K.C. remon. tag on E side 10" Willow Clump N 05° W 39.25'

Signed by *Randy J. Kolehhouse* Date 10/8/96

EARTH TECH

Surveyor's Michigan License No. 25854

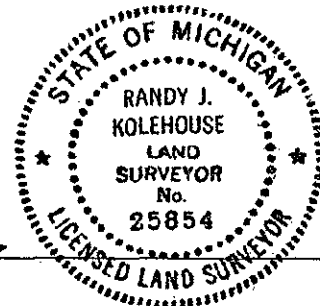

P.A. 345 1990 KENT COUNTY  
PEER APPROVED 7/25/96  
CHAIRMAN *[Signature]*

