

\$7.00
\$2.00

**SURVEY &
REMONUMENTATION**

FEB 14 1997

**LAND CORNER RECORDATION CERTIFICATE
Filing Requirement of Act 74, Mich. P.A. 1970**

For corners in **COMMISSION**

KENT COUNTY REMONUMENTATION

<u>Kent</u> (County)	Located in: Caledonia Township	Corner Code #
1. Public Land Survey	T <u>5N</u> R <u>10W</u>	<u>D-3</u>
	T _____ R _____	_____
	T _____ R _____	_____
	T _____ R _____	_____
2. Property Controlling in Section	S _____ T _____ R _____	_____
	S _____ T _____ R _____	_____
3. Miscellaneous Property in Sec.	S _____ T _____ R _____	_____
	S _____ T _____ R _____	_____

STATE OF MICHIGAN
COUNTY OF KENT
RECEIVED FOR RECORD


96 NOV -8 AM 9:19

REG. OF DEEDS
Luigi Bond

9468
Register of Deeds Stamp & File Number

4. Lot No. _____, Recorded Plat _____
5. Private Claims _____

I, Randy Kolehouse, in a field survey on April 9 19 96, do hereby certify that under requirements of P.A. 74 Michigan P.A. of 1970, the corner points mentioned in lines 1 and 2 above were in conformance with regulations and rules therefore as required in the current manual of survey instructions of the United States Department of the interior, Bureau of Land Management or by a decree of a Court of Law and/or that the corner points mentioned in lines 3, 4 and 5 above were in conformance with the rules of the Michigan Board of Land Surveyors or by a Decree of a Court of Law; established, re-established, monumented, re-monumented, recovered, found as expressed below:

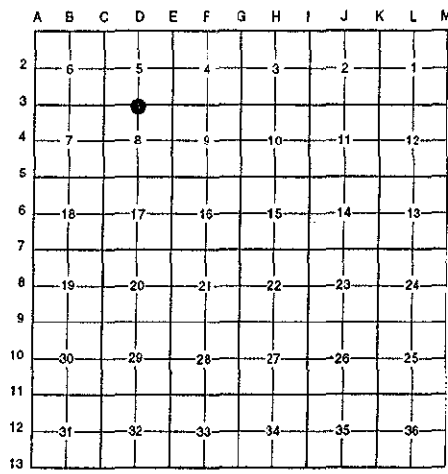

NOTE: Not more than 4 corners, all in the same town and range, may be recorded on this certificate.

A. Description of original monument and accessories and/or subsequent restoration:

D-3	1831	G.L.O. Notes	Mullett	Set Post
	1955	Witness Map	K.C. Surveyor	"X" on Pavement
	1974	L.C.R.C. #784	Exxel Engineering	3/4" Iron in Monument Box
	1978	L.C.R.C. #1173	J. Mendzinski	1" Iron in Monument Box
	1981	L.C.R.C. #2064	Nederveld & Jonker	Fnd. 3/4" Iron in Mon. Box / Set K.C. Monument
	1987	L.C.R.C. #4555	Prein & Newhof	K.C. Monument
	1991	L.C.R.C. #5951	William Byl	Fnd. and Replaced K.C. Monument in a Mon. Box

This corner was originally approved by the Kent County Remonumentation Peer Group and monumented by Nederveld & Jonker on 6/9/81 and was recorded per L.C.R.C. #2064.

B. Description of corner evidence found and/or method applied in restoring or reestablishing corner:

D-3 Found a Standard Kent County Monument 1' North of the C/L of 68th Street (bit.) running East and West on line of a tree row running South per L.C.R.C.'s #2064, #4555 and #5951 as set by Nederveld & Jonker in place of a 3/4" iron they found in a monument box which checked L.C.R.C.'s #784, #1173 and the K.C. Surveyor's records. Byl later removed and replaced K.C. monument in a monument box per L.C.R.C. #5951.

L.C.R.C. #2064

L.C.R.C. #5951

Nail & Remon. tag SW side P. pole S 30° E 160.87'
Nail & Remon. tag W side P. pole N 52° W 82.12'
Centerline B.T. 1' South

Nail & KC Remon. tag SW side P. Pole S 30° E 160.93' (m. 160.88')
Nail & KC Remon. tag W. side P. Pole N 52° W 81.98' (m. 82.01')
Nail & KC Remon. tag SW side Tw. 12" Elm S 60° E 55.81' (m. 55.75')

The selected location is accepted by me and is generally accepted by professional surveyors as the best available evidence of the position of the original corner.


C. Description of monument for corner and accessories established to perpetuate locating the position of the corner:

D-3 Standard Kent County Monument

- Nail & K.C. remon. tag on SE side 12" Elm N 55° E 54.34'
- Nail & K.C. remon. tag on SW side 12" Twin Elm S 60° E 55.75'
- Nail & K.C. remon. tag on SW side P. pole S 30° E 160.88'
- Nail & K.C. remon. tag on E side 4" x 4" wooden fence post S 05° W 56.52'
- Nail & K.C. remon. tag on SW side P. pole N 52° W 82.01'

Signed by Randy J. Kolehouse
EARTH TECH

Date 10/8/96

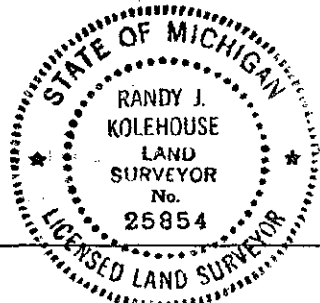

Surveyor's Michigan License No. 25854

P.A. 345 1990 KENT COUNTY

PEER APPROVED 7/25/96

CHAIRMAN Harold Huber