

SURVEY & REMONUMENTATION

\$7.00
\$2.00

FEB 14 1997

COMMISSION

LAND CORNER RECORDATION CERTIFICATE
Filing Requirement of Act 74, Mich. P.A. 1970
KENT COUNTY REMONUMENTATION

For corners in

| Kent (County) | Located in: | Caledonia Township | Corner Code # |
|------------------------------------|-------------|-----------------------|---------------|
| 1. Public Land Survey | T | 5N R 10W | D-4 |
| | T | R | |
| | T | R | |
| | T | R | |
| 2. Property Controlling in Section | S | T R | |
| | S | T R | |
| 3. Miscellaneous Property in Sec. | S | T R | |
| | S | T R | |

REG. OF DEEDS

9469

Register of Deeds Stamp & File Number

STATE OF MICHIGAN
COUNTY OF KENT
RECEIVED FOR RECORD
96 NOV -8 AM 9:19

4. Lot No. _____, Recorded Plat _____
5. Private Claims _____

I, Randy Kolehouse, in a field survey on May 7 19 96, do hereby certify that under requirements of P.A. 74 Michigan P.A. of 1970, the corner points mentioned in lines 1 and 2 above were in conformance with regulations and rules therefore as required in the current manual of survey instructions of the United States Department of the interior, Bureau of Land Management or by a decree of a Court of Law and/or that the corner points mentioned in lines 3, 4 and 5 above were in conformance with the rules of the Michigan Board of Land Surveyors or by a Decree of a Court of Law; established, re-established, monumented, re-monumented, recovered, found as expressed below:

NOTE: Not more than 4 corners, all in the same town and range, may be recorded on this certificate.

A. Description of original monument and accessories and/or subsequent restoration:

D-4 This corner was not originally set by the G.L.O.

| | | | |
|------|----------------|-------------------|-----------------------|
| 1954 | Witness Map | K.C. Surveyor | 2" Iron in Fence Post |
| 1976 | L.C.R.C. #932 | Exxel Engineering | Set Steel Fence Post |
| 1993 | L.C.R.C. #6760 | R. Roon | Steel Fence Post |

B. Description of corner evidence found and/or method applied in restoring or reestablishing corner:

D-4 Found "T" iron and old fence post 2' South on line of fence running East and West and 1' West of fence running North and South per L.C.R.C.'s #932, #6760 and the Kent County Surveyor's records. "T" iron is 0.2' West of the intersection of 1/4 lines. Accepted "T" iron as the Center of Section.

L.C.R.C. #932
Nail in sde 12" Maple NE 16.01'

L.C.R.C. #6760
Nail in 12" Hickory S 05 W 37.99' (37.10')
Nail in 12" Maple N 35° E 15.32'


The selected location is accepted by me and is generally accepted by professional surveyors as the best available evidence of the position of the original corner.

C. Description of monument for corner and accessories established to perpetuate locating the position of the corner:

D-4 Replaced "T" Iron with a Standard Kent County Monument

- Nail & K.C. remon. tag on S side 8" Ash S 89° W 8.84'
- Nail & K.C. remon. tag on NW side 14" Maple N 05° E 20.4'
- Nail & K.C. remon. tag on S side 12" Maple N 50° E 16.01'
- Nail & K.C. remon. tag on NE side 24" Maple N 79° E 23.85'

Signed by Randy J. Kolehouse Date 10/2/96
EARTH TECH
Surveyor's Michigan License No. 25854

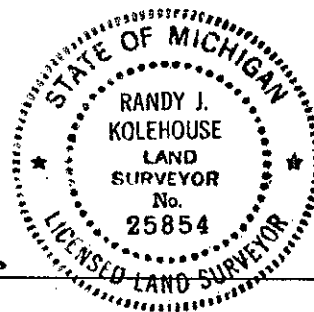

P.A. 345 1990 KENT COUNTY
PEER APPROVED 8/22/96
CHAIRMAN [Signature]

