

SURVEY & REMONUMENTATION

\$7.00
\$2.00

FEB 14 1997

LAND CORNER RECORDATION CERTIFICATE
Filing Requirement of Act 74, Mich. P.A. 1970
KENT COUNTY REMONUMENTATION

For corners in

COMMISSION

For corners in	Located in:	Corner Code #
<u>Kent</u> (County)	Caledonia Township	
1. Public Land Survey	T <u>5N</u> R <u>10W</u>	<u>D-5</u>
	T _____ R _____	_____
	T _____ R _____	_____
	T _____ R _____	_____
2. Property Controlling in Section	S _____ T _____ R _____	_____
	S _____ T _____ R _____	_____
3. Miscellaneous Property in Sec.	S _____ T _____ R _____	_____
	S _____ T _____ R _____	_____

STATE OF MICHIGAN
COUNTY OF KENT
RECEIVED FOR RECORD

96 NOV -9 AM 9:19

REG. OF DEEDS


9470

Register of Deeds Stamp & File Number

4. Lot No. _____, Recorded Plat _____
5. Private Claims _____

I, Randy Kolehouse, in a field survey on April 29 19 96, do hereby certify that under requirements of P.A. 74 Michigan P.A. of 1970, the corner points mentioned in lines 1 and 2 above were in conformance with regulations and rules therefore as required in the current manual of survey instructions of the United States Department of the interior, Bureau of Land Management or by a decree of a Court of Law and/or that the corner points mentioned in lines 3, 4 and 5 above were in conformance with the rules of the Michigan Board of Land Surveyors or by a Decree of a Court of Law; established, re-established, monumented, re-monumented, recovered, found as expressed below:

NOTE: Not more than 4 corners, all in the same town and range, may be recorded on this certificate.

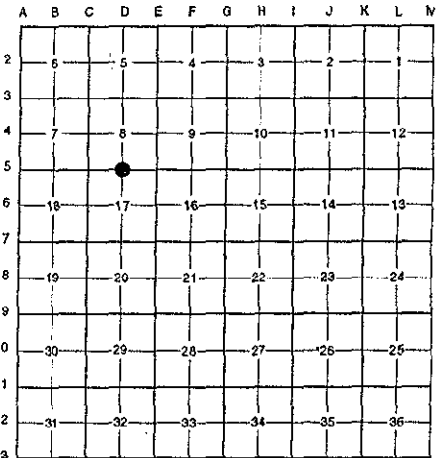

A. Description of original monument and accessories and/or subsequent restoration:

D-5	1831	G.L.O. Notes	Mullett	Set Post
	1946-63	Witness Map	K.C. Surveyor	Concrete Monument
	1972	L.C.R.C. #234	F. Spicer	1" "0" Iron
	1981	L.C.R.C. #2538	J. Bueche	Fnd. Capped 1/2" Re-rod (Exxel) / Set K.C. Monument
	1991	L.C.R.C. #5952	William Byl	K.C. Monument

This corner was originally approved by the Kent County Remonumentation Peer Group and monumented by J. Bueche on 12/17/81 and was recorded per L.C.R.C. #2538.

B. Description of corner evidence found and/or method applied in restoring or reestablishing corner:

D-5 Found a Standard Kent County Monument in the C/L of 76th Street (bit.) running East and West per L.C.R.C.'s #2538 and #5952 as set by J. Bueche in place of a 1/2" x 18" capped re-rod (Exxel) he found which checked L.C.R.C. #234 and the K.C. Surveyor's records.

L.C.R.C. #2538

- K. C. Remon. tag & nail in West side 8" Beech S 10° W 39.53'
- K. C. Remon. tag & nail in NE side 10" Ash S 30° E 38.62'
- K. C. Remon. tag & nail in SE side 14" Maple S 60° W 54.65'
- K. C. Remon. tag & nail in West side 8" Maple N 10° E 29.95'
- K. C. Remon. tag & nail in NW side 20" Walnut N 50° E 56.57' fence & tree North
- C/L blktp. E & W is South 1' M/L

L.C.R.C. #5952

- KC Remon. tag & nail W. side 10" Beech S 10° W 39.50' (m. 39.60')
- KC Remon. tag & nail NE side 10" Ash S 30° E 38.62'
- KC Remon. tag & nail SE side 18" Maple S 60° W 54.66'
- KC Remon. tag & nail W. side 8" Maple N 10° E 29.88'
- KC Remon. tag & nail 24" Walnut N 50° E 56.53'
- KC Remon. tag & nail W side P. Pole N 00° E 63.08'


The selected location is accepted by me and is generally accepted by professional surveyors as the best available evidence of the position of the original corner.

C. Description of monument for corner and accessories established to perpetuate locating the position of the corner:

D-5 Standard Kent County Monument

- Nail & K.C. remon. tag on W side 10" Beech S 10° W 39.60'
- Nail & K.C. remon. tag on NE side 10" Ash S 30° E 38.62'
- Nail & K.C. remon. tag on SE side 18" Maple S 60° W 54.66'
- Nail & K.C. remon. tag on W side 8" Maple N 10° E 29.88'
- Nail & K.C. remon. tag on NW side 24" Walnut N 50° E 56.53'
- Nail & K.C. remon. tag on W side P. pole N 00° E 63.08'

Signed by Randy J. Kolehouse Date 10/29/96
EARTH TECH
Surveyor's Michigan License No. 25854

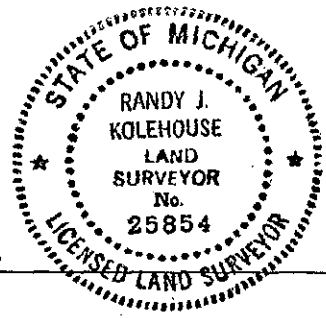

P.A. 345 1990 KENT COUNTY
PEER APPROVED 1/29/96
CHAIRMAN Thomas Habers