

FEB 14 1997

COMMISSION

\$7.00
\$2.00

LAND CORNER RECORDATION CERTIFICATE
Filing Requirement of Act 74, Mich. P.A. 1970
KENT COUNTY REMONUMENTATION

For corners in

Kent (County)	Located in:	Caledonia Township	Corner Code #
1. Public Land Survey	T <u>5N</u>	R <u>10W</u>	<u>D-6</u>
	T _____	R _____	_____
	T _____	R _____	_____
	T _____	R _____	_____
2. Property Controlling in Section	S _____	T _____	R _____
	S _____	T _____	R _____
3. Miscellaneous Property in Sec.	S _____	T _____	R _____
	S _____	T _____	R _____

STATE OF MICHIGAN
COUNTY OF KENT
RECEIVED FOR RECORD

96 NOV -8 AM 9:19

REG. OF DEEDS
[Signature]
9471


Register of Deeds Stamp & File Number

4. Lot No. _____, Recorded Plat _____

5. Private Claims _____

I, Randy Kolehouse, in a field survey on May 1 19 96, do hereby certify that under requirements of P.A. 74 Michigan P.A. of 1970, the corner points mentioned in lines 1 and 2 above were in conformance with regulations and rules therefore as required in the current manual of survey instructions of the United States Department of the Interior, Bureau of Land Management or by a decree of a Court of Law and/or that the corner points mentioned in lines 3, 4 and 5 above were in conformance with the rules of the Michigan Board of Land Surveyors or by a Decree of a Court of Law; established, re-established, monumented, re-monumented, recovered, found as expressed below:

NOTE: Not more than 4 corners, all in the same town and range, may be recorded on this certificate.

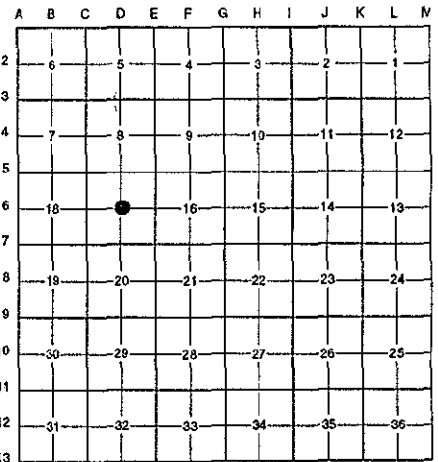

A. Description of original monument and accessories and/or subsequent restoration:

D-6 This corner was not originally set by the G.L.O.

N/A	Witness Map	K.C. Surveyor	Concrete Monument
1973	L.C.R.C. #461	F.Spicer	Concrete Monument
1993	L.C.R.C. #6756	R. Roon	Concrete Monument with 3/8" Rebar

B. Description of corner evidence found and/or method applied in restoring or reestablishing corner:

D-6 Found a concrete monument with a 3/8" rebar per L.C.R.C.'s #461, #6756 and the Kent County Surveyor's records. Concrete monument with 3/8" rebar is 5.2' West and 0.2' South of the intersection of 1/4 lines. Accepted monument as the Center of Section.

L.C.R.C. #461

12" Beech N 20° E 28.30'
16" Ash N 30° W 27.8'

L.C.R.C. #6756

Nail & Tag in 24" Ash - N 20 W 27.62'
Nail & Tag in 18" Beech - N 25 E 28.52'
Nail & Tag in 15" Beech - S 65 W 37.95'
Nail & Tag in 22" Cherry - South - 6.50'

The selected location is accepted by me and is generally accepted by professional surveyors as the best available evidence of the position of the original corner.

C. Description of monument for corner and accessories established to perpetuate locating the position of the corner:

D-6 Set a Kent County Remonumentation Cap on the Existing Concrete Monument and 3/8" Rebar

Nail & K.C. remon. tag on 24" Ash N 20° W 27.62'
Nail & K.C. remon. tag on 18" Beech N 25° E 28.52'
Nail & K.C. remon. tag on 15" Beech S 65° W 37.95'
Nail & K.C. remon. tag on 22" Cherry Due South 6.50'

Signed by Randy J. Kolehouse
EARTH TECH

Date 10/8/96

Surveyor's Michigan License No. 25854



P.A. 345 1990 KENT COUNTY

PEER APPROVED 1/22/96
CHAIRMAN [Signature]