

SURVEY & REMONUMENTATION

FEB 14 1997

COMMISSION

LAND CORNER RECORDATION CERTIFICATE

Filing Requirement of Act 74, Mich. P.A. 1970

KENT COUNTY REMONUMENTATION

For corners in

Kent (County)	Located in: Caledonia Township	Corner Code #
1. Public Land Survey	T <u>5N</u> R <u>10W</u>	<u>D-7</u>
	T _____ R _____	_____
	T _____ R _____	_____
	T _____ R _____	_____
2. Property Controlling in Section	S _____ T _____ R _____	_____
	S _____ T _____ R _____	_____
3. Miscellaneous Property in Sec.	S _____ T _____ R _____	_____
	S _____ T _____ R _____	_____

STATE OF MICHIGAN
COUNTY OF KENT
RECEIVED FOR RECORD

96 NOV -8 AM 9:19

REG. OF DEEDS

Lucy Spauld


9472

Register of Deeds Stamp & File Number

4. Lot No. _____, Recorded Plat _____
5. Private Claims _____

I, Randy Kolehouse, in a field survey on April 9 19 96, do hereby certify that under requirements of P.A. 74 Michigan P.A. of 1970, the corner points mentioned in lines 1 and 2 above were in conformance with regulations and rules therefore as required in the current manual of survey instructions of the United States Department of the interior, Bureau of Land Management or by a decree of a Court of Law and/or that the corner points mentioned in lines 3, 4 and 5 above were in conformance with the rules of the Michigan Board of Land Surveyors or by a Decree of a Court of Law; established, re-established, monumented, re-monumented, recovered, found as expressed below:

NOTE: Not more than 4 corners, all in the same town and range, may be recorded on this certificate.

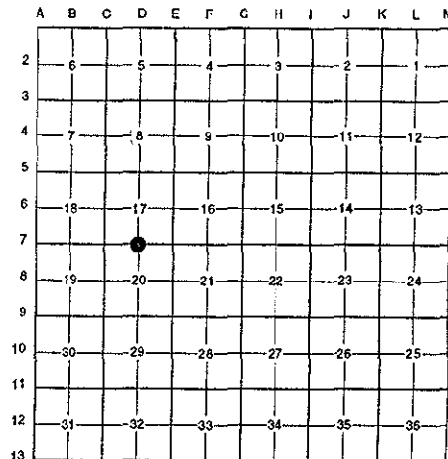

A. Description of original monument and accessories and/or subsequent restoration:

D-7	1831	G.L.O. Notes	Mullett	Set Post
	1964	Witness Map	K.C. Surveyor	Iron in Monument Box
	1973	L.C.R.C. #650	F. Spicer	Iron in Monument Box
	1981	L.C.R.C. #2539	J. Bueche	Fnd. 3/4" Iron in Mon. Box / Set K.C. Monument in Mon. Box
	1991	L.C.R.C. #5953	William Byl	K.C. Monument in Mon. Box

This corner was originally approved by the Kent County Remonumentation Peer Group and monumented by J. Bueche on 12/17/81 and was recorded per L.C.R.C. #2539.

B. Description of corner evidence found and/or method applied in restoring or reestablishing corner:

D-7 Found a Standard Kent County Monument in a monument box 1.5' North of the C/L of 84th Street (bit.) running East and West on line of a fence running North per L.C.R.C.'s #2539 and #5953 as set by J. Bueche in place of a 3/4" x 21" iron he found in a monument box which checked L.C.R.C. #650 and the K.C. Surveyor's records.

L.C.R.C. #2539

L.C.R.C. #5953

- K. C. Remon. tag & nail in top of guard rail post S 65° E 39.56'
- K. C. Remon. tag & nail in top of guard rail post S 10° W 17.71'
- K. C. Remon. tag & nail in top of guard rail post S 60° W 32.12'
- K. C. Remon. tag & nail in West root 34" Twin Oak N 10° E 41.17'
- K. C. Remon. tag & nail in South side Power pole N 75° W 114.62'
- PK nail in South side Power pole N 70° E 122.64'
- C/L blktp. E & W is South 1.5' M/L
- Fence North

- KC Remon. tag & nail in top of guard rail post S 65° E 39.60' (m. 38.64')
- KC Remon. tag & nail in top of guard rail post S 10° W 17.99' (m. 18.11')
- KC Remon. tag & nail in top of guard rail post S 60° W 32.20' (m. 32.32')
- KC Remon. tag & nail in West root 34" Twin Oak N 10° E 41.06' (m. 41.00')
- KC Remon. tag & nail S. side P. Pole N 75° W 114.55' (m. 114.39')
- KC Remon. tag & nail S. side P. Pole N 80° E 120.34'

The selected location is accepted by me and is generally accepted by professional surveyors as the best available evidence of the position of the original corner.

C. Description of monument for corner and accessories established to perpetuate locating the position of the corner:

D-7 Standard Kent County Monument in a Monument Box

- Nail & K.C. remon. tag on top guard rail post S 65° E 38.64'
- Nail & K.C. remon. tag on top guard rail post S 10° W 18.11'
- Nail & K.C. remon. tag on top guard rail post S 60° W 32.32'
- Nail & K.C. remon. tag on W root of 34" Twin Oak N 10° E 41.00'
- Nail & K.C. remon. tag on S side P. pole N 75° W 114.39'
- Nail & K.C. remon. tag on S side P. pole N 80° E 120.34'

Signed by Randy J. Kolehouse Date 10/2/96
EARTH TECH

Surveyor's Michigan License No. 25854

P.A. 345 1990 KENT COUNTY

PEER APPROVED 7/25/96
CHAIRMAN Randy Kolehouse

