

SURVEY & REMONUMENTATION COMMISSION
 FEB 14 1997

LAND CORNER RECORDATION CERTIFICATE
 Filing Requirement of Act 74, Mich. P.A. 1970
 KENT COUNTY REMONUMENTATION


For corners in

Kent (County)	Located in: Caledonia Township	Corner Code #
1. Public Land Survey	T <u>5N</u> R <u>10W</u>	<u>D-9</u>
	T _____ R _____	_____
	T _____ R _____	_____
	T _____ R _____	_____
2. Property Controlling in Section	S _____ T _____ R _____	_____
	S _____ T _____ R _____	_____
3. Miscellaneous Property in Sec.	S _____ T _____ R _____	_____
	S _____ T _____ R _____	_____

STATE OF MICHIGAN
 COUNTY OF KENT
 RECEIVED FOR RECORD
 96 NOV -8 AM 9:19
 REG. OF DEEDS
Luci St. Grand
9473
 Register of Deeds Stamp & File Number

4. Lot No. _____, Recorded Plat _____
 5. Private Claims _____

I, Randy Kolehouse, in a field survey on April 10 19 96, do hereby certify that under requirements of P.A. 74 Michigan P.A. of 1970, the corner points mentioned in lines 1 and 2 above were in conformance with regulations and rules therefore as required in the current manual of survey instructions of the United States Department of the interior, Bureau of Land Management or by a decree of a Court of Law and/or that the corner points mentioned in lines 3, 4 and 5 above were in conformance with the rules of the Michigan Board of Land Surveyors or by a Decree of a Court of Law; established, re-established, monumented, re-monumented, recovered, found as expressed below:

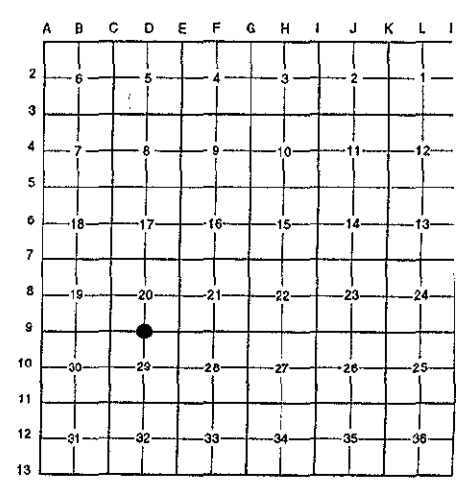

NOTE: Not more than 4 corners, all in the same town and range, may be recorded on this certificate.

A. Description of original monument and accessories and/or subsequent restoration:

D-9	1831	G.L.O. Notes	Mullett	Set Post
	N/A	Witness Map	K.C. Surveyor	Iron in Sidewalk
	1974	L.C.R.C. #643	Medema, Van Kooten & Assoc.	1/2" Iron
	1973	L.C.R.C. #650	F. Spicer	1/2" Iron
	1981	L.C.R.C. #2540	J. Bueche	Fnd. 1/2" Iron / Set K.C. Monument
	1991	L.C.R.C. #5954	William Byl	K.C. Monument

This corner was originally approved by the Kent County Remonumentation Peer Group and monumented by J. Bueche on 12/23/81 and was recorded per L.C.R.C. #2540.

B. Description of corner evidence found and/or method applied in restoring or reestablishing corner:

D-9 Found a Standard Kent County Monument on line of a fence and tree row running North, East and West per L.C.R.C.'s #2540 and #5954 as set by J. Bueche in place of a 1/2" x 24" iron he found which checked L.C.R.C. #643, and the K.C. Surveyor's records.

L.C.R.C. #2540

- K. C. Remon. tag & nail in North side 14" W. Cherry East 26.05'
- K. C. Remon. tag & nail in East side 34" Beech N 10° E 29.43'
- K. C. Remon. tag & nail in South side 16" Beech S 65° W 27.55'
- Fence North & East

L.C.R.C. #5954


- KC Remon. tag & nail N. side 24" W. Cherry N 90° E 25.90' (m. 25.77')
- KC Remon. tag & nail E (W) side 36" Beech N 10° E 29.41' (m. 29.86')
- KC Remon. tag & nail S. side 24" Beech S 65° W 27.51' (m. 27.58')
- KC Remon. tag & nail N. side 20" Ash N 65° W 63.96' (m. 63.99')

The selected location is accepted by me and is generally accepted by professional surveyors as the best available evidence of the position of the original corner.

C. Description of monument for corner and accessories established to perpetuate locating the position of the corner:

D-9 Standard Kent County Monument

- Nail & K.C. remon. tag on W side 36" Beech N 10° E 29.86'
- Nail & K.C. remon. tag on N side 24" Cherry N 90° E 25.77'
- Nail & K.C. remon. tag on SE side 24" Beech S 65° W 27.58'
- Nail & K.C. remon. tag on N side 16" Tree S 75° W 27.10'
- Nail & K.C. remon. tag on N side 20" Ash N 65° W 63.99'

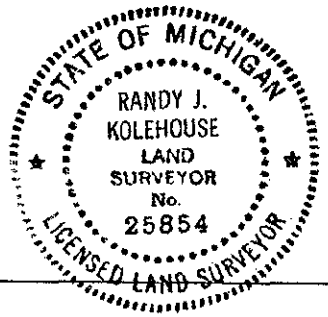

Signed by Randy J. Kolehouse Date 10/8/96
 EARTH TECH

Surveyor's Michigan License No. 25854

P.A. 345 1990 KENT COUNTY
 PEER APPROVED 7/25/96
 CHAIRMAN James Huber