

SURVEY & REMONUMENTATION

FEB 14 1997

COMMISSION LAND CORNER RECORDATION CERTIFICATE
Filing Requirement of Act 74, Mich. P.A. 1970

For corners in


KENT COUNTY REMONUMENTATION

<u>Kent</u> (County)	Located in: Caledonia Township	Corner Code #
1. Public Land Survey	T <u>5N</u> R <u>10W</u>	<u>D-11</u>
	T _____ R _____	_____
	T _____ R _____	_____
	T _____ R _____	_____
2. Property Controlling in Section	S _____ T _____ R _____	_____
	S _____ T _____ R _____	_____
3. Miscellaneous Property in Sec.	S _____ T _____ R _____	_____
	S _____ T _____ R _____	_____

REG. OF DEEDS
[Signature]
 96 NOV -8 AM 9:19
 STATE OF MICHIGAN
 COUNTY OF KENT
 RECEIVED FOR RECORD
9474
 Register of Deeds Stamp & File Number

4. Lot No. _____, Recorded Plat _____
 5. Private Claims _____

I, Randy Kolehouse, in a field survey on April 10 19 96, do hereby certify that under requirements of P.A. 74 Michigan P.A. of 1970, the corner points mentioned in lines 1 and 2 above were in conformance with regulations and rules therefore as required in the current manual of survey instructions of the United States Department of the interior, Bureau of Land Management or by a decree of a Court of Law and/or that the corner points mentioned in lines 3, 4 and 5 above were in conformance with the rules of the Michigan Board of Land Surveyors or by a Decree of a Court of Law; established, re-established, monumented, re-monumented, recovered, found as expressed below:

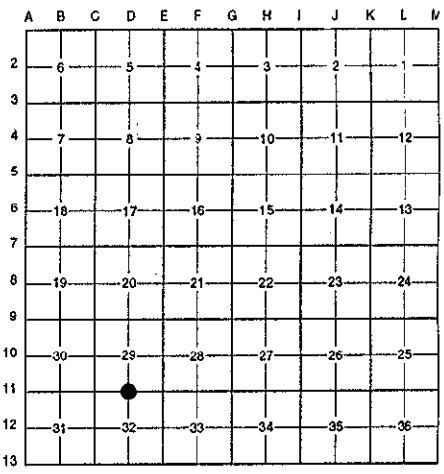

NOTE: Not more than 4 corners, all in the same town and range, may be recorded on this certificate.

A. Description of original monument and accessories and/or subsequent restoration:

D-11	1831	G.L.O. Notes	Mullett	Set Post
	1937	Witness Map	K.C. Surveyor	Concrete Monument
	1973	L.C.R.C. #373	Exxel Engineering	3/4" Iron
	1972	L.C.R.C. #409	P. VanPoolen	3/4" Iron
	1981	L.C.R.C. #2291	Nederveld & Associates	Fnd. 3/4" Iron / Set K.C. Monument
	1991	L.C.R.C. #5955	William Byl	K.C. Monument

This corner was originally approved by the Kent County Remonumentation Peer Group and monumented by Nederveld & Associates on 7/24/96 and was recorded per L.C.R.C. #2291.

B. Description of corner evidence found and/or method applied in restoring or reestablishing corner:

D-11 Found a Standard Kent County Monument 3' North of the C/L of 100th Street (gravel) running East and West on line of a fence and tree row running South per L.C.R.C.'s #2291 and #5955 as set by Nederveld & Associates in place of a 3/4" round iron they found which checked L.C.R.C.'s #409, #373 and the K.C. Surveyor's records.

L.C.R.C. #2291

- NE cor. garage fnd. S 45° E 129.55'
- Nail & K.C. Remon. tag N side 10" Oak N 55° W 32.98'
- Nail & K.C. Remon. tag E side P. pole S 00° E 48.85'
- Nail & K.C. Remon. tag NW side 24" Maple S 50° W 30.90'

L.C.R.C. #5955


- NE cor. garage fnd. S 45° E 129.55' (m. 129.58')
- Nail & KC Remon. tag N side 12" Oak N 55° W 32.89' (m. 32.86')
- Nail & KC Remon. tag E. side P. Pole S 00° E 48.85'
- Nail & KC Remon. tag NW side 30" Maple S 50° W 30.90' (m. 30.98')

The selected location is accepted by me and is generally accepted by professional surveyors as the best available evidence of the position of the original corner.

C. Description of monument for corner and accessories established to perpetuate locating the position of the corner:

D-11 Standard Kent County Monument

- NE cor. garage fndn. S 45° E 129.58'
- Nail & K.C. remon. tag on NE side 12" Twin Oak N 55° W 32.86'
- Nail & K.C. remon. tag on E side P. pole S 00° E 48.85'
- Nail & K.C. remon. tag on NW side 30" Maple S 50° W 30.98'
- NW cor. hse. fndn. S 05° E 84.36'

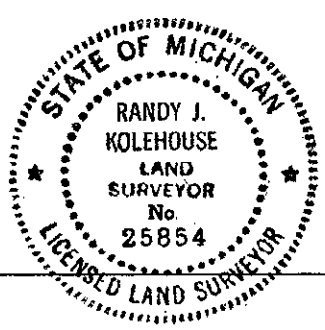

Signed by Randy J. Kolehouse Date 10/9/96

Surveyor's Michigan License No. 25854

P.A. 345 1990 KENT COUNTY
 PEER APPROVED 7/25/96
 CHAIRMAN [Signature]