

**\$7.00** FEB 14 1997  
**\$2.00** COMMISSION

**LAND CORNER RECORDATION CERTIFICATE**  
**Filing Requirement of Act 74, Mich. P.A. 1970**  
**KENT COUNTY REMONUMENTATION**

For corners in

Kent (County)	Located in: Caledonia Township	Corner Code #
1. Public Land Survey	T <u>5N</u> R <u>10W</u>	<u>E-3</u>
	T _____ R _____	_____
	T _____ R _____	_____
	T _____ R _____	_____
2. Property Controlling in Section	S _____ T _____ R _____	_____
	S _____ T _____ R _____	_____
3. Miscellaneous Property in Sec.	S _____ T _____ R _____	_____
	S _____ T _____ R _____	_____

STATE OF MICHIGAN  
 COUNTY OF KENT  
 RECEIVED FOR RECORD

96 NOV -8 AM 9:19

REG. OF DEEDS  
*[Signature]*  
**9478**

Register of Deeds Stamp & File Number


4. Lot No. \_\_\_\_\_, Recorded Plat \_\_\_\_\_  
 5. Private Claims \_\_\_\_\_

I, Randy Kolehouse, in a field survey on April 4 19 96, do hereby certify that under requirements of P.A. 74 Michigan P.A. of 1970, the corner points mentioned in lines 1 and 2 above were in conformance with regulations and rules therefore as required in the current manual of survey instructions of the United States Department of the Interior, Bureau of Land Management or by a decree of a Court of Law and/or that the corner points mentioned in lines 3, 4 and 5 above were in conformance with the rules of the Michigan Board of Land Surveyors or by a Decree of a Court of Law; established, re-established, monumented, re-monumented, recovered, found as expressed below:

**NOTE: Not more than 4 corners, all in the same town and range, may be recorded on this certificate.**

**A. Description of original monument and accessories and/or subsequent restoration:**

E-3	1831	G.L.O. Notes	Mullett	Set Post
	N/A	Witness Map	K.C. Surveyor	Iron in Monument Box
	1971	L.C.R.C. #29	M. Chambers	1" Iron in Monument Box
	1981	L.C.R.C. #2058	Nederveld & Jonker	Fnd. 1" Iron in Monument Box / Set K.C. Monument
	1991	L.C.R.C. #5958	William Byl	K.C. Monument

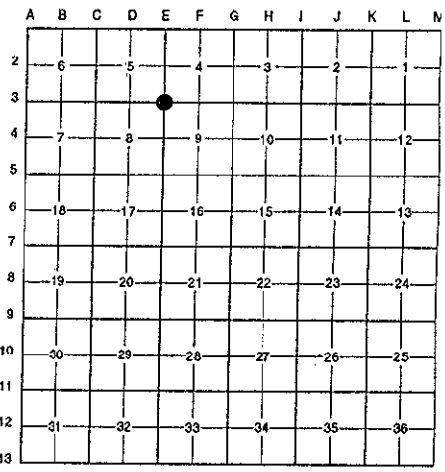

This corner was originally approved by the Kent County Remonumentation Peer Group and monumented by Nederveld & Jonker on 6/9/81 and was recorded per L.C.R.C. #2058.

**B. Description of corner evidence found and/or method applied in restoring or reestablishing corner:**

E-3 Found a Standard Kent County Monument at the C/L intersection of 68th Street (bit.) running East and West and Cherry Valley Avenue (bit.) running South and on line of a fence row running North per L.C.R.C.'s #2058 and #5958 as set by Nederveld & Jonker in place of a 1" iron they found in a monument box which checked L.C.R.C. #29 and the K.C. Surveyor's records.

**L.C.R.C. #2058**

- Nail & Remon. tag in W side M.B.T. pole S 15° E 71.40'
- Nail & Remon. tag N side P. pole S 61° W 72.52'
- Nail & Remon. tag E'ly side 8" Elm N 45° W 68.34'
- Nail & Remon. tag E'ly side 12" Oak N 00° E 33.16'
- Center top 3" steel fence post N 00° E 34.90'

**L.C.R.C. #5958**

- Nail & KC Remon. tag W. side CATV Pole S 15° E 71.54'
- Nail & KC Remon. tag N. side P. Pole S 61° W 72.46'
- Nail & KC Remon. tag E'ly side 15" Elm N 45° W 68.34'
- PK Nail in top 12" Oak stump N 00° E 33.01'
- Center top 3" steel fence post N 00° E 34.90'
- Nail & KC Remon. tag W side Lt. Pole N 20° W 33.57'

The selected location is accepted by me and is generally accepted by professional surveyors as the best available evidence of the position of the original corner.

**C. Description of monument for corner and accessories established to perpetuate locating the position of the corner:**

**E-3 Standard Kent County Monument**

- Nail & K.C. remon. tag on W side CATV pole S 15° E 71.54'
- Nail & K.C. remon. tag on N side P. pole S 61° W 72.46'
- Nail & K.C. remon. tag on E side 18" Elm N 45° W 68.34'
- P.K. nail top 12" Oak Stump N 00° E 33.01'
- Center top 3" steel fence post N 00° E 34.90'
- Nail & K.C. remon. tag on W side Lt. pole N 20° W 33.57'

Signed by Randy J. Kolehouse  
 EARTH TECH

Date 10/8/96

Surveyor's Michigan License No. 25854

P.A. 345 1990 KENT COUNTY  
 PEER APPROVED 7/25/96  
 CHAIRMAN [Signature]

