

**SURVEY & REMONUMENTATION**

\$7.00  
\$2.00

FEB 14 1997

COMMISSION

**LAND CORNER RECORDATION CERTIFICATE**  
Filing Requirement of Act 74, Mich. P.A. 1970  
KENT COUNTY REMONUMENTATION

For corners in

Kent (County)	Located in: Caledonia Township	Corner Code #
1. Public Land Survey	T <u>5N</u> R <u>10W</u>	<u>E-4</u>
	T _____ R _____	_____
	T _____ R _____	_____
	T _____ R _____	_____
2. Property Controlling in Section	S _____ T _____ R _____	_____
	S _____ T _____ R _____	_____
3. Miscellaneous Property in Sec.	S _____ T _____ R _____	_____
	S _____ T _____ R _____	_____

STATE OF MICHIGAN  
COUNTY OF KENT  
RECEIVED FOR RECORD  
95 NOV -8 AM 9:19  
REG. OF DEEDS  
*David Stand*


**9479**

Register of Deeds Stamp & File Number

4. Lot No. \_\_\_\_\_, Recorded Plat \_\_\_\_\_  
5. Private Claims \_\_\_\_\_

I, Randy Kolehouse, in a field survey on April 4 19 96, do hereby certify that under requirements of P.A. 74 Michigan P.A. of 1970, the corner points mentioned in lines 1 and 2 above were in conformance with regulations and rules therefore as required in the current manual of survey instructions of the United States Department of the interior, Bureau of Land Management or by a decree of a Court of Law and/or that the corner points mentioned in lines 3, 4 and 5 above were in conformance with the rules of the Michigan Board of Land Surveyors or by a Decree of a Court of Law; established, re-established, monumented, re-monumented, recovered, found as expressed below:

**NOTE: Not more than 4 corners, all in the same town and range, may be recorded on this certificate.**

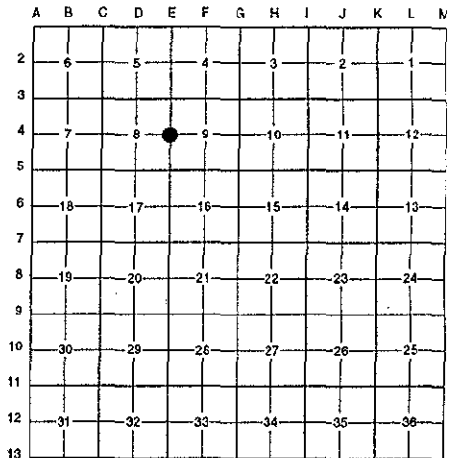

**A. Description of original monument and accessories and/or subsequent restoration:**

E-4	1831	G.L.O. Notes	Mullett	Set Post
	1949	Witness Map	K.C. Surveyor	Monument Box
	1971	L.C.R.C. #29	M. Chambers	1" Iron in Monument Box
	1981	L.C.R.C. #2059	Nederveld & Jonker	Fnd. 1" Iron in Mon. Box / Set K.C. Monument
	1991	L.C.R.C. #5959	William Byl	K.C. Monument in a Monument Box

This corner was originally approved by the Kent County Remonumentation Peer Group and monumented by Nederveld & Jonker on 6/9/81 and was recorded per L.C.R.C. #2059.

**B. Description of corner evidence found and/or method applied in restoring or reestablishing corner:**

E-4 Found a Standard Kent County Monument in a monument box in the C/L of Cherry Valley Avenue (bit.) running North and South on line of a tree row running East per L.C.R.C.'s #2059 and #5959 as set by Nederveld & Jonker in place of 1" iron they found in a monument box which checked L.C.R.C. #29 and the K.C. Surveyor's records.

L.C.R.C. #2059

Nail & Remon. tag S side 18" Hickory S 90° E 39.44'  
NE cor. porch fnd. S 69° W 73.40'  
Nail & Remon. tag W side M.B.T. pole S 35° E 35.71'

L.C.R.C. #5959


Nail & KC Remon. tag S. side 18" Hickory S 90° E 39.42'  
NE cor. porch fnd. S 69° W 73.40'  
Nail & KC Remon. tag W. side M.B.T. Pole S 35° E 35.73'  
Steel bar & cap (EXXEL) S 90° E 32.98'  
SE cor. hse. (brick) S 50° W 89.85'  
NE cor. gar. fnd. S 85° W 104.45'

The selected location is accepted by me and is generally accepted by professional surveyors as the best available evidence of the position of the original corner.

**C. Description of monument for corner and accessories established to perpetuate locating the position of the corner:**

E-4 Standard Kent County Monument in a Monument Box

Nail & K.C. remon. tag on S side 18" Hickory S 90° E 39.42'  
NE cor. porch fndn. S 69° W 73.40'  
Nail & K.C. remon. tag on W side MBT pole S 35° E 35.73'  
Steel bar and cap (EXXEL) S 90° E 32.98'  
SE cor. hse. (brick) S 50° W 89.85'  
NE cor. gar. fndn. S 85° W 104.45'

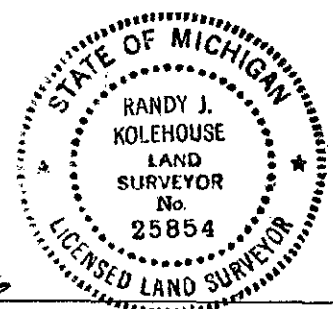

Signed by Randy J. Kolehouse Date 10/8/96  
EARTH TECH

Surveyor's Michigan License No. 25854

P.A. 345 1990 KENT COUNTY

PEER APPROVED 7/25/96

CHAIRMAN [Signature]