

**SURVEY &
REMONUMENTATION**

FEB 14 1997

COMMISSION

**LAND CORNER RECORDATION CERTIFICATE
Filing Requirement of Act 74, Mich. P.A. 1970
KENT COUNTY REMONUMENTATION**

For corners in

Kent
(County)

Located in: Caledonia
Township

Corner Code #

- | | | | |
|------------------------------------|-------------|--------------|------------|
| 1. Public Land Survey | T <u>5N</u> | R <u>10W</u> | <u>E-7</u> |
| | T | R | |
| | T | R | |
| | T | R | |
| 2. Property Controlling in Section | S | T | R |
| | S | T | R |
| 3. Miscellaneous Property in Sec. | S | T | R |
| | S | T | R |

4. Lot No. _____, Recorded Plat _____
5. Private Claims _____

STATE OF MICHIGAN
COUNTY OF KENT
RECEIVED FOR RECORD


96 NOV -8 AM 9:19

REG. OF DEEDS
Lucy Bond
9482

Register of Deeds Stamp & File Number

I, Randy Kolehouse, in a field survey on April 4 19 96, do hereby certify that under requirements of P.A. 74 Michigan P.A. of 1970, the corner points mentioned in lines 1 and 2 above were in conformance with regulations and rules therefore as required in the current manual of survey instructions of the United States Department of the interior, Bureau of Land Management or by a decree of a Court of Law and/or that the corner points mentioned in lines 3, 4 and 5 above were in conformance with the rules of the Michigan Board of Land Surveyors or by a Decree of a Court of Law; established, re-established, monumented, re-monumented, recovered, found as expressed below:

NOTE: Not more than 4 corners, all in the same town and range, may be recorded on this certificate.

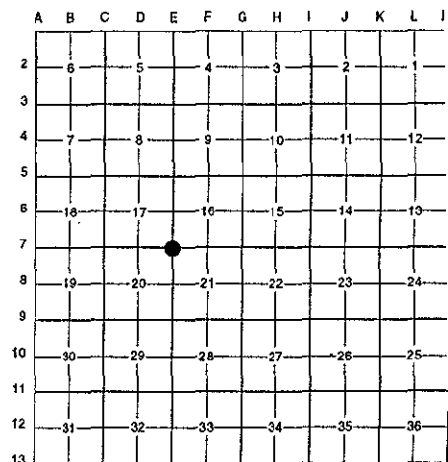

A. Description of original monument and accessories and/or subsequent restoration:

E-7	1831	G.L.O. Notes	Mullett	Set Post
	1955	Notes	Williams & Works	Iron in Monument Box
	1961	Witness Map	K.C. Surveyor	1" Iron in Monument Box
	1973	L.C.R.C. #651	F. Spicer	Iron in Monument Box
	1976	L.C.R.C. #956	P. McPherson	Iron in Monument Box
	1981	L.C.R.C. #2542	J. Bueche	Fnd. 3/4" x 18" Iron in Mon. Box / Set K.C. Monument
	1991	L.C.R.C. #5962	William Byl	K.C. Monument in Monument Box

This corner was originally approved by the Kent County Remonumentation Peer Group and monumented by J. Bueche on 12/17/81 and was recorded per L.C.R.C. #2542.

B. Description of corner evidence found and/or method applied in restoring or reestablishing corner:

E-7 Found a Standard Kent County Monument 8.5' South of the C/L of 84th Street (bit.) running East and West and on the C/L of Cherry Valley Avenue (bit.) running North and South per L.C.R.C.'s #2542 and #5962 as set by J. Bueche in place of a 3/4" x 18" iron he found in a monument box which checked L.C.R.C.'s #956 and #651, the 1955 notes of Williams & Works, and the K.C. Surveyor's records.

L.C.R.C. #2542

L.C.R.C. #5962

K. C. Remon. tag & nail in West side Guy pole N 35° E 63.65'	KC Remon. tag & nail W. side Guy Pole N 35° E 63.63'
K. C. Remon. tag & nail in East side Tel. pole S 30° E 69.66'	"X" cut in conc. curb S 55° W 30.32'
"X" cut in conc. curb S 55° W 30.32'	KC Remon. tag & nail SW side P. Pole N 40° W 57.82'
	KC Remon. tag & nail E. side Guy Pole S 30° E 70.02'


The selected location is accepted by me and is generally accepted by professional surveyors as the best available evidence of the position of the original corner.

C. Description of monument for corner and accessories established to perpetuate locating the position of the corner:

E-7 Standard Kent County Monument

- Nail & K.C. remon. tag on W side Guy pole N 35° E 63.63'
- Nail & K.C. remon. tag on SW side P. pole N 40° W 57.82'
- Nail & K.C. remon. tag on E side Guy pole S 30° E 70.02'
- "X" cut in conc. curb S 55° W 30.32'

Signed by *Randy J. Kolehouse* Date 10/8/96
EARTH TECH
Surveyor's Michigan License No. 25854

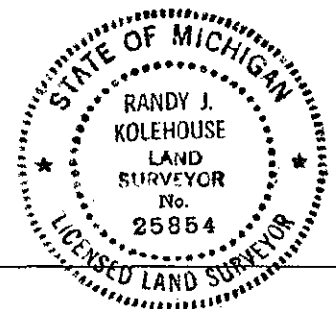

P.A. 345 1990 KENT COUNTY
PEER APPROVED 7/29/96
CHAIRMAN *Tom Bueche*