

SURVEY &
 REMONUMENTATION
 \$7.00
 \$2.00
 FEB 14 1997
 COMMISSION

LAND CORNER RECORDATION CERTIFICATE
Filing Requirement of Act 74, Mich. P.A. 1970
KENT COUNTY REMONUMENTATION


For corners in Kent (County) Located in: Caledonia Township Corner Code # _____

1. Public Land Survey	T. <u>5N</u>	R. <u>10W</u>	Corner Code # <u>E-13</u>
	T. _____	R. _____	_____
	T. _____	R. _____	_____
	T. _____	R. _____	_____
2. Property Controlling in Section	S. _____	T. _____	R. _____
	S. _____	T. _____	R. _____
3. Miscellaneous Property in Sec.	S. _____	T. _____	R. _____
	S. _____	T. _____	R. _____

STATE OF MICHIGAN
 COUNTY OF KENT
 RECEIVED FOR RECORD
 96 NOV -8 AM 9:20
 REG. OF DEEDS
Lucy Bond
9488
 Register of Deeds Stamp & File Number

4. Lot No. _____, Recorded Plat _____
 5. Private Claims _____

I, Randy Kolehouse, in a field survey on April 5 19 96, do hereby certify that under requirements of P.A. 74 Michigan P.A. of 1970, the corner points mentioned in lines 1 and 2 above were in conformance with regulations and rules therefore as required in the current manual of survey instructions of the United States Department of the interior, Bureau of Land Management or by a decree of a Court of Law and/or that the corner points mentioned in lines 3, 4 and 5 above were in conformance with the rules of the Michigan Board of Land Surveyors or by a Decree of a Court of Law; established, re-established, monumented, re-monumented, recovered, found as expressed below:

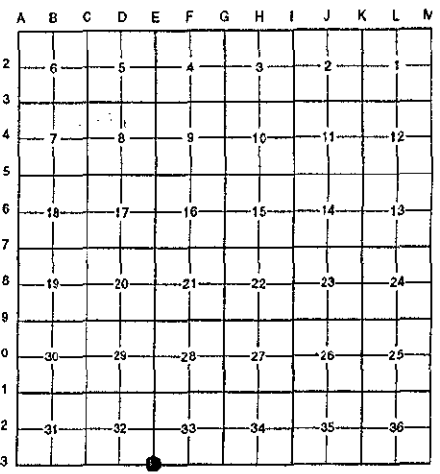

NOTE: Not more than 4 corners, all in the same town and range, may be recorded on this certificate.

A. Description of original monument and accessories and/or subsequent restoration:

E-13	1817	G.L.O. Notes	L. Lyon	Set Post
	N/A	Witness Map	K.C. Surveyor	Iron on Top Stone
	1930	Notes	Williams & Works	Stone
	1961	Notes	Williams & Works	Iron
	1965	Notes	Williams & Works	Iron and Boat Spike in Mon. Box
	1983	L.C.R.C. #3696	Jonker Land Survey	Fnd. 1" Solid Bar & Boat Spike in Mon. Box / Set K.C. Monument in Mon. Box
	1991	L.C.R.C. #5968	William Byl	K.C. Monument in Mon. Box

Note: This corner is not common with E-1, T4N, R10W.

This corner was originally approved by the Kent County Remonumentation Peer Group and monumented by Rob Jonker on 5/6/83 and was recorded per L.C.R.C. #3696.

B. Description of corner evidence found and/or method applied in restoring or reestablishing corner:

E-13 Found a Standard Kent County Monument in a monument box 13' West of the C/L of Cherry Valley Avenue (bit.) running North and South and on the C/L of 108th Street (bit.) running East and West per L.C.R.C.'s #3696 and #5968 as set by Rob Jonker in place of a 1" solid bar in a monument box with a boat spike in a monument box he found which checked the 1930, 1961 and 1965 Williams and Works' notes and the K.C. Surveyor's records.

L.C.R.C. #3696

L.C.R.C. #5968

Remon. tag on NE side g. pole N 50° W 57.52'	Nail & KC Remon. tag NE side Guy Pole N 50° W 57.49' (m. 57.46')
S.E. corner concrete H/W S 75° W 71.65'	SE corner concrete H/W S 75° W 71.65'
NW corner concrete H/W S 10° W 93.60'	NW corner concrete H/W S 10° W 93.60' (m. 93.65')
NE corner concrete H/W S 25° E 100.8'	NE corner concrete H/W S 25° E 100.80' (m. 100.87')
Boat spike in mon. box East 33.07'	Boat spike in Mon. Box N 90° E 33.07'
C/L N-S pavt. East 13.6' ml	Set Nail & KC Remon. tag SW side Guy Pole S 60° E 80.53' (m. 80.49')

The selected location is accepted by me and is generally accepted by professional surveyors as the best available evidence of the position of the original corner.


C. Description of monument for corner and accessories established to perpetuate locating the position of the corner:

E-13 Standard Kent County Monument in a Monument Box

Nail & K.C. remon. tag on SW side Guy pole S 60° E 80.49'	NW cor. headwall S 10° W 93.65'
Boat spike in mon. box N 90° E 33.07'	NE cor. headwall S 25° E 100.87'
Nail & K.C. remon. tag on NE side Guy pole N 50° W 57.46'	
SE cor. headwall S 75° W 71.65'	

Signed by Randy J. Kolehouse Date 10/8/96
 EARTH TECH

Surveyor's Michigan License No. 25854

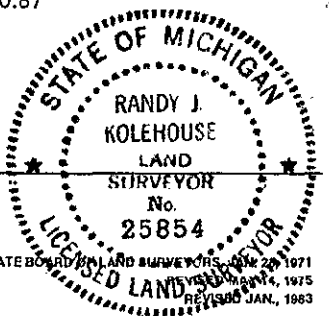

P.A. 345 1990 KENT COUNTY
 PEER APPROVED 7/25/96