

**SURVEY & REMONUMENTATION**

\$7.00  
\$2.00

FEB 14 1997

**LAND CORNER RECORDATION CERTIFICATE**  
**Filing Requirement of Act 74, Mich. P.A. 1970**  
**KENT COUNTY REMONUMENTATION**

For corners in **COMMISSION**

Kent (County)	Located in: Caledonia Township	Corner Code #
1. Public Land Survey	T <u>5N</u> R <u>10W</u>	<u>E-7</u>
	T _____ R _____	_____
	T _____ R _____	_____
	T _____ R _____	_____
2. Property Controlling in Section	S _____ T _____ R _____	_____
	S _____ T _____ R _____	_____
3. Miscellaneous Property in Sec.	S _____ T _____ R _____	_____
	S _____ T _____ R _____	_____

STATE OF MICHIGAN  
COUNTY OF KENT  
RECEIVED FOR RECORD

96 NOV -8 AM 9:20


REG. OF DEEDS  
*David J. ...*

**9493**

Register of Deeds Stamp & File Number

4. Lot No. \_\_\_\_\_, Recorded Plat \_\_\_\_\_
5. Private Claims \_\_\_\_\_

I, Randy Kolehouse, in a field survey on April 9 19 96, do hereby certify that under requirements of P.A. 74 Michigan P.A. of 1970, the corner points mentioned in lines 1 and 2 above were in conformance with regulations and rules therefore as required in the current manual of survey instructions of the United States Department of the interior, Bureau of Land Management or by a decree of a Court of Law and/or that the corner points mentioned in lines 3, 4 and 5 above were in conformance with the rules of the Michigan Board of Land Surveyors or by a Decree of a Court of Law; established, re-established, monumented, re-monumented, recovered, found as expressed below:

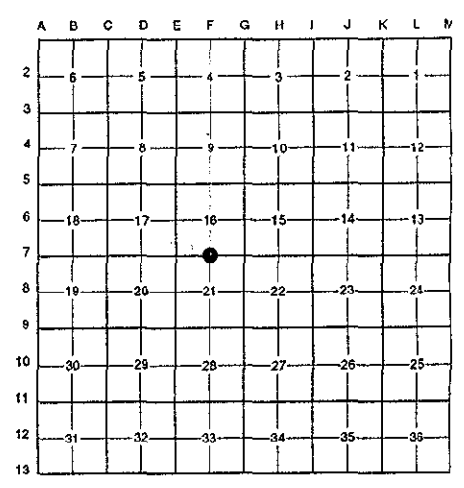

**NOTE: Not more than 4 corners, all in the same town and range, may be recorded on this certificate.**

**A. Description of original monument and accessories and/or subsequent restoration:**

F-7	1831	G.L.O. Notes	Mullett	Set Post
	1961	Witness Map	K.C. Surveyor	1" Iron in Monument Box
	1976	L.C.R.C. #956	P. McPherson	1/2" Pipe in Monument Box
	1981	L.C.R.C. #2055	Nederveld & Jonker	Iron in Monument Box
	1991	L.C.R.C. #5971	William Byl	K.C. Monument in a Monument Box

This corner was originally approved by the Kent County Remonumentation Peer Group and monumented by Nederveld & Jonker on 7/7/81 and was recorded per L.C.R.C. #2055.

**B. Description of corner evidence found and/or method applied in restoring or reestablishing corner:**

F-7 Found a Standard Kent County Monument in a monument box 4' North of the C/L of 84th Street (bit.) running East and West on line of tree row running North and South per L.C.R.C.'s #2055 and #5971 as set by Nederveld & Jonker in place of an iron in a monument box they found which checked L.C.R.C. #956 and the K.C. Surveyor's records.

**L.C.R.C. #2055**

**L.C.R.C. #5971**

NW cor. hse. fld. #6810 S 45° W 142.16'	NW cor. hse. fld. S 45° W 142.16' (m. 142.25')
Nail & K.C. Remon. tag E side T. pole S 00° W 55.46'	Nail & KC Remon. tag E. (W) side T. Pole S 00° W 55.46' (m. 55.65')
Nail & K.C. Remon. tag W side P. pole N 52° E 69.82'	Nail & KC Remon. tag W side P. Pole N 52° E 69.82' (m. 69.75')
Nail & K.C. Remon. tag E side 24° Cherry N 38° W 54.08'	Nail & KC Remon. tag E. side 30° Cherry N 38° W 54.25' (m. 54.19')
Centerline 4' South	Steel bar N 00° E 33.00'

The selected location is accepted by me and is generally accepted by professional surveyors as the best available evidence of the position of the original corner.


**C. Description of monument for corner and accessories established to perpetuate locating the position of the corner:**

F-7 Standard Kent County Monument in a monument box

- NW cor. hse. fld. S 45° W 142.25'
- Nail & K.C. remon. tag on W side P. pole S 00° W 55.65'
- Nail & K.C. remon. tag on NW side P. pole N 52° E 69.75'
- Nail & K.C. remon. tag on E side 30° Cherry N 38° W 54.19'
- Steel Bar N 00° W 33.00'
- Capped rebar S 00° W 32.93'

Signed by *Randy J. Kolehouse*  
EARTH TECH

Date 10/8/96

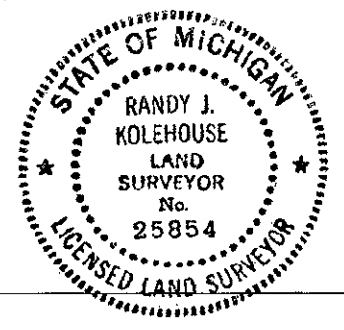

Surveyor's Michigan License No. 25854

P.A. 345 1990 KENT COUNTY  
PEER APPROVED 7/25/96