

**SURVEY & REMONUMENTATION**

FEB 14 1997

**LAND CORNER RECORDATION CERTIFICATE**  
**Filing Requirement of Act 74, Mich. P.A. 1970**  
**KENT COUNTY REMONUMENTATION**

For corners in **COMMISSION**

Kent (County)	Located in: Caledonia Township	Corner Code #
1. Public Land Survey	T <u>5N</u> R <u>10W</u>	<u>F-9</u>
	T _____ R _____	_____
	T _____ R _____	_____
	T _____ R _____	_____
2. Property Controlling in Section	S _____ T _____ R _____	_____
	S _____ T _____ R _____	_____
3. Miscellaneous Property in Sec.	S _____ T _____ R _____	_____
	S _____ T _____ R _____	_____

STATE OF MICHIGAN  
 COUNTY OF KENT  
 RECEIVED FOR RECORD

96 NOV -8 AM 9:20


REG. OF DEEDS  
*W. J. Bond*  
**9494**

Register of Deeds Stamp & File Number

4. Lot No. \_\_\_\_\_, Recorded Plat \_\_\_\_\_  
 5. Private Claims \_\_\_\_\_

I, Randy Kolehouse, in a field survey on April 9 19 96, do hereby certify that under requirements of P.A. 74 Michigan P.A. of 1970, the corner points mentioned in lines 1 and 2 above were in conformance with regulations and rules therefore as required in the current manual of survey instructions of the United States Department of the interior, Bureau of Land Management or by a decree of a Court of Law and/or that the corner points mentioned in lines 3, 4 and 5 above were in conformance with the rules of the Michigan Board of Land Surveyors or by a Decree of a Court of Law; established, re-established, monumented, re-monumented, recovered, found as expressed below:

**NOTE: Not more than 4 corners, all in the same town and range, may be recorded on this certificate.**

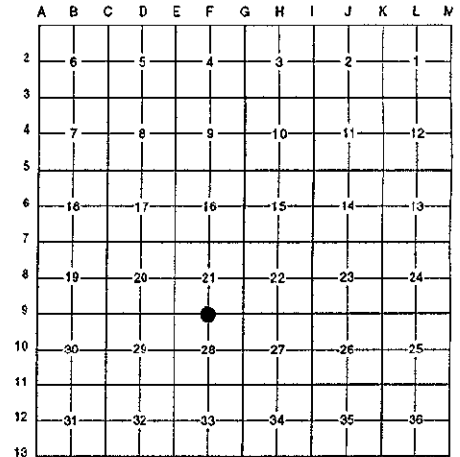

**A. Description of original monument and accessories and/or subsequent restoration:**

F-9	1831	G.L.O. Notes	Mullett	Set Post
	1958	Witness Map	K.C. Surveyor	Iron
	1973	L.C.R.C. #613	F.E. Spicer	3/4" Iron
	1975	L.C.R.C. #838	J. McCloskey	1/2" Iron
	1982	L.C.R.C. #2655	Jonker Land Surveys	Fnd. 1/2" Iron / Set K.C. Monument
	1991	L.C.R.C. #5972	William Byl	K.C. Monument

This corner was originally approved by the Kent County Remonumentation Peer Group and monumented by Rob Jonker on 2/15/82 and was recorded per L.C.R.C. #2655.

**B. Description of corner evidence found and/or method applied in restoring or reestablishing corner:**

F-9 Found a Standard Kent County Monument 10' South of the C/L of 92nd Street (gravel) running East and West per L.C.R.C.'s #2655 and #5972 as set by Rob Jonker in place of a 1/2" iron in top of a 2" x 30" pinched iron he found which checked L.C.R.C.'s #838, #613 and the K.C. Surveyor's records.

L.C.R.C. #2655

L.C.R.C. #5972

Remon. tag on W side p. pole N 10° W 107.76'  
 Remon. tag on S side p. pole N 68° E 156.80'  
 Remon. tag on S side 60" Maple S 88° E 179.90'  
 C/L E-W gravel is 10' N m/l


Nail & KC Remon. tag W. side P. Pole N 10° W 107.76' (m. 107.81')  
 Nail & KC Remon. tag S. side P. Pole N 68° E 156.80'  
 Nail & KC Remon. tag S. side 60" Maple S 88° E 179.90' (m. 179.95')  
 C/L E-W gravel is 10' N. m/l

The selected location is accepted by me and is generally accepted by professional surveyors as the best available evidence of the position of the original corner.

**C. Description of monument for corner and accessories established to perpetuate locating the position of the corner:**

F-9 Standard Kent County Monument

Nail & K.C. remon. tag on W side P. pole N 10° W 107.81'  
 Nail & K.C. remon. tag on S side P. pole N 68° E 156.80'  
 Nail & K.C. remon. tag on S side 60" Maple S 88° E 179.95'  
 Nail & K.C. remon. tag on N side 8" Maple S 85° W 87.73'  
 C/L gravel road E/W is 10' N

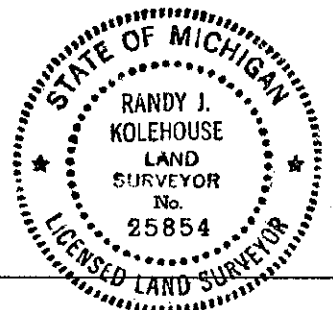

Signed by Randy J. Kolehouse Date 10/8/96  
 EARTH TECH

Surveyor's Michigan License No. 25854  
 P.A. 345 1990 KENT COUNTY  
 PEER APPROVED 7/25/96  
 CHAIRMAN Harry Huber