

**SURVEY & REMONUMENTATION**

**\$7.00**  
**\$2.00**

FEB 14 1997

**COMMISSION LAND CORNER RECORDATION CERTIFICATE**  
**Filing Requirement of Act 74, Mich. P.A. 1970**

For corners in

**KENT COUNTY REMONUMENTATION**

<u>Kent</u> (County)	Located in: Caledonia Township	Corner Code #
1. Public Land Survey	T <u>5N</u> R <u>10W</u>	<u>F-12</u>
	T _____ R _____	_____
	T _____ R _____	_____
	T _____ R _____	_____
2. Property Controlling in Section	S _____ T _____ R _____	_____
	S _____ T _____ R _____	_____
3. Miscellaneous Property in Sec.	S _____ T _____ R _____	_____
	S _____ T _____ R _____	_____

4. Lot No. \_\_\_\_\_, Recorded Plat \_\_\_\_\_  
5. Private Claims \_\_\_\_\_

STATE OF MICHIGAN  
COUNTY OF KENT  
RECEIVED FOR RECORD


96 NOV -9 AM 9:15

REG. OF DEEDS  
*[Signature]*  
**9427**

Register of Deeds Stamp & File Number

I, Randy Kolehouse, in a field survey on August 14 19 96, do hereby certify that under requirements of P.A. 74 Michigan P.A. of 1970, the corner points mentioned in lines 1 and 2 above were in conformance with regulations and rules therefore as required in the current manual of survey instructions of the United States Department of the Interior, Bureau of Land Management or by a decree of a Court of Law and/or that the corner points mentioned in lines 3, 4 and 5 above were in conformance with the rules of the Michigan Board of Land Surveyors or by a Decree of a Court of Law; established, re-established, monumented, re-monumented, recovered, found as expressed below:

**NOTE: Not more than 4 corners, all in the same town and range, may be recorded on this certificate.**

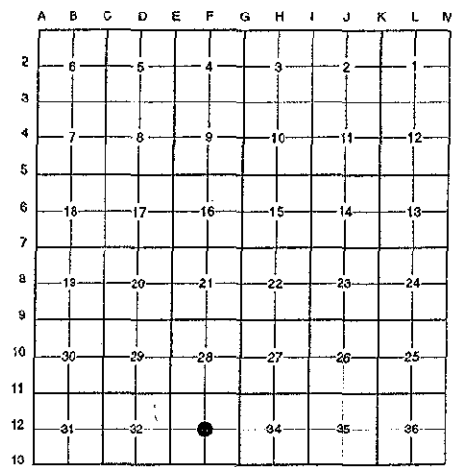

A. Description of original monument and accessories and/or subsequent restoration:

F-12 This corner was not originally set by the G.L.O.

Found no additional information on record. Also checked Kent County Surveyor's witness map and found no information pertaining to this corner.

P.A. 345 1990 KENT COUNTY  
PEER APPROVED 8/22/96  
CHAIRMAN *[Signature]*

B. Description of corner evidence found and/or method applied in restoring or reestablishing corner:


F-12 Set monument at the intersection of 1/4 lines.

The selected location is accepted by me and is generally accepted by professional surveyors as the best available evidence of the position of the original corner.

C. Description of monument for corner and accessories established to perpetuate locating the position of the corner:

F-12 Set a Standard Kent County Monument

- Nail & K.C. remon. tag on SW side 8" Ash S 58° E 32.26'
- Nail & K.C. remon. tag on NE side 10" Ash S 20° E 65.53'
- Nail & K.C. remon. tag on W side 8" Ash S 18° W 44.90'
- Nail & K.C. remon. tag on N side Util. pole N 78° W 185.06'
- East-West overhead utility line North 35'

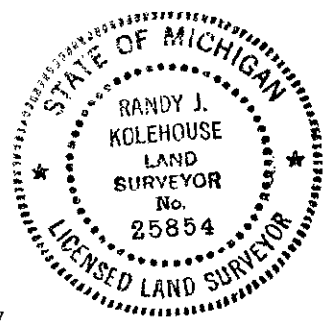

Signed by *[Signature]*  
EARTH TECH

Date 10/25/96

Surveyor's Michigan License No. 25854