

\$7.00
\$2.00

FEB 14 1997

COMMISSION

LAND CORNER RECORDATION CERTIFICATE
Filing Requirement of Act 74, Mich. P.A. 1970
KENT COUNTY REMONUMENTATION

For corners in

Kent (County)	Located in: Caledonia Township	Corner Code #
1. Public Land Survey	T <u>5N</u> R <u>10W</u>	<u>F-13</u>
	T _____ R _____	_____
	T _____ R _____	_____
	T _____ R _____	_____
2. Property Controlling in Section	S _____ T _____ R _____	_____
	S _____ T _____ R _____	_____
3. Miscellaneous Property in Sec.	S _____ T _____ R _____	_____
	S _____ T _____ R _____	_____

STATE OF MICHIGAN
COUNTY OF KENT
RECEIVED FOR RECORD

96 NOV -8 AM 9:20

REG. OF DEEDS
[Signature]
9496

Register of Deeds Stamp & File Number

4. Lot No. _____, Recorded Plat _____
5. Private Claims _____

I, Randy Kolehouse, in a field survey on April 5 19 96, do hereby certify that under requirements of P.A. 74 Michigan P.A. of 1970, the corner points mentioned in lines 1 and 2 above were in conformance with regulations and rules therefore as required in the current manual of survey instructions of the United States Department of the Interior, Bureau of Land Management or by a decree of a Court of Law and/or that the corner points mentioned in lines 3, 4 and 5 above were in conformance with the rules of the Michigan Board of Land Surveyors or by a Decree of a Court of Law; established, re-established, monumented, re-monumented, recovered, found as expressed below:

NOTE: Not more than 4 corners, all in the same town and range, may be recorded on this certificate.

A. Description of original monument and accessories and/or subsequent restoration:

F-13	1817	G.L.O. Notes	L. Lyon	Set Post
	1930	Survey Notes	Williams & Works	Calc. Loc.
	1983	L.C.R.C. #3697	Jonker Land Survey	Set 1/4 Corner on Twp. Line / Set K.C. Monument in B.T.
	1991	L.C.R.C. #5974	William Byl	K.C. Monument

Note: This corner is or is not common with F-1, T4N, R10W.

This corner was originally approved by the Kent County Remonumentation Peer Group and monumented by Rob Jonker on 4/6/83 and was recorded per L.C.R.C. #3697.

B. Description of corner evidence found and/or method applied in restoring or reestablishing corner:

F-13 Found a Standard Kent County Monument 2' North of the C/L of 108th Street on line of fence and tree row running North per L.C.R.C.'s #3697 and #5974 as set by Rob Jonker who set 1/4 corner on the Township line and 2642' East of SW corner section per Williams & Works records.

L.C.R.C. #3697

L.C.R.C. #5974

Remon. tag on NW side 30" Sycamore N 25° E 37.24'
Remon. tag on S side 36" Sycamore N 75° E 78.83'
Remon. tag on NE side 30" Maple S 40° E 84.43'
S.E. corner conc. H/W S 65° W 100.54'


Nail & KC Remon. tag NW side 36" Sycamore N 25° E 36.62' (m. 36.52')
Nail & KC Remon. tag S. side 40" Sycamore N 75° E 78.93' (m. 78.90')
Nail & KC Remon. tag NE side 36" Maple S 40° E 84.90'
SE cor. conc. H/S S 65° W 100.54' (m. 100.61')
Nail & KC Remon. tag SE side P. Pole S 70° W 156.83'
Steel bar & cap (Jonker) N 90° E 35.39'

The selected location is accepted by me and is generally accepted by professional surveyors as the best available evidence of the position of the original corner.

C. Description of monument for corner and accessories established to perpetuate locating the position of the corner:

F-13 Standard Kent County Monument

Nail & K.C. remon. tag on NW side 36" Sycamore N 25° E 36.52'
Nail & K.C. remon. tag on S side 40" Sycamore N 75° E 78.90'
Nail & K.C. remon. tag on NE side 36" Maple S 40° E 84.90'
SE cor. conc. headwall S 65° W 100.61'
Nail & K.C. remon. tag on SE side P. pole S 70° W 156.83'
Capped rebar (Jonker) N 90° E 35.39'

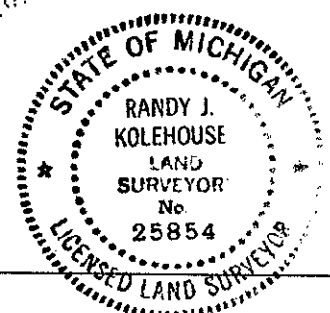

Signed by Randy J. Kolehouse
EARTH TECH

Date 10/8/96

Surveyor's Michigan License No. 25854

P.A. 345 1990 KENT CC. NTY

PEER APPROVED 7/25/96

CHAIRMAN [Signature]