

**SURVEY & REMONUMENTATION**

FEB 14 1997

KENT COUNTY REMONUMENTATION

COMMISSION

LAND CORNER RECORDATION CERTIFICATE  
Filing Requirement of Act 74, Mich. P.A. 1970

For corners in  
KENT COUNTY  
(County)

Located In:	Corner Code #
T 5N R 10W	G-1
T R	
T R	
T R	
S T R	
S T R	
S T R	
S T R	

- Public Land Survey
- Property Controlling in Section
- Miscellaneous Property in Sec.

- Lot No. \_\_\_\_\_, Recorded Plat \_\_\_\_\_
- Private Claims \_\_\_\_\_

STATE OF MICHIGAN  
COUNTY OF KENT  
RECEIVED FOR RECORD

96 MAR 20 AM 8:48

REG. OF DEEDS

*Luis Staud*

**9015**

Register of Deeds Stamp & File Number

I, Kirk Breitels, in a field survey on Feb. 27, 1996 do hereby state that under requirements of P.A. 74, Michigan P.A. of 1970, the corner points mentioned in lines 1 and 2 above were in conformance with regulations and rules therefore as required in the current manual of survey instructions of the United States Department of the Interior, Bureau of Land Management or by a decree of a Court of Law and /or that the corner points mentioned in lines 3, 4 and 5 above were in conformance with the rules of the Michigan Board of Land Surveyors or by a Decree of a Court of Law; established, re-established, monumented, recovered, found as expressed below:

NOTE: Not more than 2 corners, all in the same town and range, may be recorded on this certificate.

	A	B	C	D	E	F	G	H	I	J	K	L	M
1													
2	6		5		4		3		2		1		
3													
4	7		8		9		10		11		12		
5													
6	18		17		16		15		14		13		
7													
8	19		20		21		22		23		24		
9													
10	30		29		28		27		26		25		
11													
12	31		32		33		34		35		36		
13													

A. Description of original monument and accessories and/or subsequent restoration:

G-1	1830	GLO	Mullett	Set Post
		Kent Co. Wit.		Iron
	1977	LCRC #983	Bonnema	3/4" Iron
	1984	LCRC #3704	Chettleburgh	Set Kent County Monument
	1994	LCRC #7080	Bueche	Kent County Monument

P.A. 345 1990 KENT COUNTY  
PEER APPROVED 2/7/96  
CHAIRMAN *Harry Fisher*

The position of this corner was previously approved by the Kent County Remonumentation Peer Group, monumented by Thomas Chettleburgh on 1/25/84 and was recorded per LCRC #3704

B. Description of corner evidence found and/or method applied in restoring or reestablishing corner:

G-1 Found standard Kent Co. Mon. (Harrison) per witnesses from above LCRC as set by Thomas Chettleburgh on Twp. Line 1.53' North of the Iron Pipe he found. Said Iron Pipe checks with Kent Co. Wit. and LCRC #983.  
LCRC #3704 & #7080


Nail in 9" Hickory	N30°E 17.31'	Kent Co. Mon. (G-13, T6N, R10W)
Nail in 14" W. Cherry	N49°E 30.40'	East 73.53'
Nail in Twin 13" Oak	S22°E 12.14'	Iron Pipe South 1.53'
Nail in 12" Hickory	N67°W 44.65'	
Nail in 12" Maple	N42°W 18.84'	

The selected location is accepted by me and is generally accepted by professional surveyors as the best available evidence of the position of the original corner.

C. Description of monument for corner and accessories established to perpetuate locating the position of the corner:

G-1 Standard Kent County Monument

New Nail & KC Remon. tag SE side	12" Hickory	N30°E	17.33'
Nail & KC Remon. tag W. side	16" W. Cherry	N49°E	30.40'
New Nail & KC Remon. tag NE side	Twin 14" Oak	S22°E	12.17'
New Nail & KC Remon. tag SW side	14" Hickory	N67°W	44.65'
Kent Co. Mon. (G-13, T6N, R10W)		East	73.59'
Iron Pipe		South	1.55'

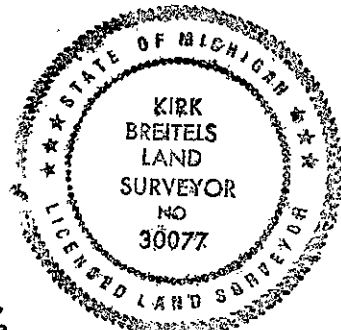

Signed by *Kirk Breitels*  
Surveyor's Michigan License No. 30077

Date 3/1/96