

\$7.00  
\$2.00

FEB 14 1997

COMMISSION

LAND CORNER RECORDATION CERTIFICATE  
Filing Requirement of Act 74, Mich. P.A. 1970  
KENT COUNTY REMONUMENTATION

For corners in

<u>Kent</u> (County)	Located in: Caledonia Township	Corner Code #
1. Public Land Survey	T <u>5N</u> R <u>10W</u>	<u>G-13</u>
	T _____ R _____	_____
	T _____ R _____	_____
	T _____ R _____	_____
2. Property Controlling in Section	S _____ T _____ R _____	_____
	S _____ T _____ R _____	_____
3. Miscellaneous Property in Sec.	S _____ T _____ R _____	_____
	S _____ T _____ R _____	_____

STATE OF MICHIGAN  
COUNTY OF KENT  
RECEIVED FOR RECORD


96 NOV -8 AM 9:22

REG. OF DEEDS  
*Lucy St. Paul*  
9509

Register of Deeds Stamp & File Number

4. Lot No. \_\_\_\_\_, Recorded Plat \_\_\_\_\_
5. Private Claims \_\_\_\_\_

I, Randy Kolehouse, in a field survey on April 5 19 96, do hereby certify that under requirements of P.A. 74 Michigan P.A. of 1970, the corner points mentioned in lines 1 and 2 above were in conformance with regulations and rules therefore as required in the current manual of survey instructions of the United States Department of the interior, Bureau of Land Management or by a decree of a Court of Law and/or that the corner points mentioned in lines 3, 4 and 5 above were in conformance with the rules of the Michigan Board of Land Surveyors or by a Decree of a Court of Law; established, re-established, monumented, re-monumented, recovered, found as expressed below:

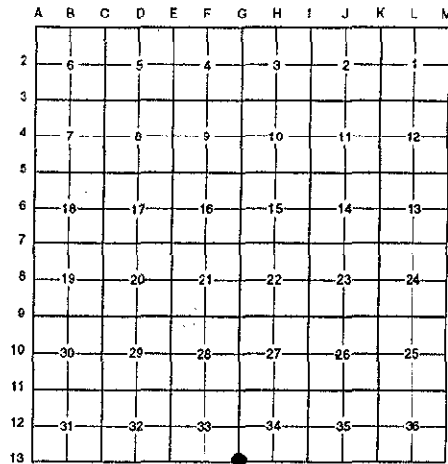

NOTE: Not more than 4 corners, all in the same town and range, may be recorded on this certificate.

A. Description of original monument and accessories and/or subsequent restoration:

G-13 1817	G.L.O. Notes	L. Lyon	Set Post
1944	Witness Map	K.C. Surveyor	Iron
1983	L.C.R.C. #3219	Exxel Engineering	"T" Iron
1983	L.C.R.C. #3586	J. Bueche	Fnd. 6" "T" Iron / Set K.C. Monument
1991	L.C.R.C. #5982	William Byl	K.C. Monument

Note: This corner is not common with G-1, T4N, R10W.

This corner was originally approved by the Kent County Remonumentation Peer Group and monumented by J. Bueche on 10/4/83 and was recorded per L.C.R.C. #3586.

B. Description of corner evidence found and/or method applied in restoring or reestablishing corner:

G-13 Found a Standard Kent County Monument 8.5' North of the C/L of 108th Street (bit.) running East and West on line of a tree row running North per L.C.R.C.'s #3586 and #5982 as set by J. Bueche in place of 6" "T" iron on top of a 1-1/2" x 24" iron he found which checked L.C.R.C. #3219 and the K.C. Surveyor's records.

L.C.R.C. #3586

K.C. Remon. tag & nail in S. side of 28" Maple N 80° E 119.33'  
K.C. Remon. tag & nail in W. side of 16" Spruce S 35° E 38.62'  
K.C. Remon. tag & nail in W. side of 12" Spruce S 15° W 31.31'  
K.C. Remon. tag & nail in N. side of 16" Spruce S 75° W 90.38'  
K.C. Remon. tag & nail in N. side of 36" Maple N 75° W 55.68'  
C/L blacktop road E - W is south 8.5' ± on tree line North

L.C.R.C. #5982


K.C. Remon. tag & nail in S. side of 28" Maple N 80° E 119.33' (m. 119.27')  
K.C. Remon. tag & nail in W. side of 16" Spruce S 35° E 38.65' (m. 38.62')  
K.C. Remon. tag & nail in W. side of 12" Spruce S 15° W 31.31' (m. 31.34')  
K.C. Remon. tag & nail in N. side of 16" Spruce S 75° W 90.38'  
K.C. Remon. tag & nail in N. side of 36" Maple N 75° W 54.82' (m. 54.79')

The selected location is accepted by me and is generally accepted by professional surveyors as the best available evidence of the position of the original corner.

C. Description of monument for corner and accessories established to perpetuate locating the position of the corner:

G-13 Standard Kent County Monument

Nail & K.C. remon. tag on S side 28" Maple N 80° E 119.27'  
Nail & K.C. remon. tag on W side 16" Spruce S 35° E 38.62'  
Nail & K.C. remon. tag on W side 12" Spruce S 15° W 31.34'  
Nail & K.C. remon. tag on N side 16" Spruce S 75° W 90.38'  
Nail & K.C. remon. tag on N side 36" Maple N 75° W 54.79'  
Caped iron (Jonker) N 90° E 40.90'

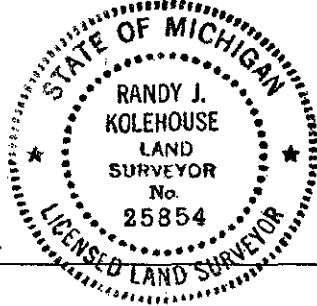

Signed by Randy J. Kolehouse

Date 10/8/96

Surveyor's Michigan License No. 25854

P.A. 345 1990 KENT COUNTY  
PEER APPROVED 7/25/96  
CHAIRMAN Dennis Hubert