

SURVEY & REMONUMENTATION

FEB 14 1997

COMMISSION

KENT COUNTY REMONUMENTATION

LAND CORNER RECORDATION CERTIFICATE
Filing Requirement of Act 74, Mich. P.A. 1970

For corners in
KENT COUNTY

(County)

Located in:	Corner Code #	
1. Public Land Survey	T5N R10W	H-1
	T R	
	T R	
	T R	
2. Property Controlling in Section	S T R	
	S T R	
3. Miscellaneous Property in Sec.	S T R	
	S T R	

REG. OF DEEDS

Handwritten signature

96 JUN -7 AM 8:28

STATE OF MICHIGAN
COUNTY OF KENT
RECEIVED FOR RECORD

9175

Register of Deeds Stamp & File Number

4. Lot No. _____, Recorded Plat _____
5. Private Claims _____

	A	B	C	D	E	F	G	H	I	J	K	L	M
1													
2	6		5		4		3		2		1		
3													
4	7		8		9		10		11		12		
5													
6	18		17		16		15		14		13		
7													
8	19		20		21		22		23		24		
9													
10	30		29		28		27		26		25		
11													
12	31		32		33		34		35		36		
13													

I, **Kirk Breitels**, in a field survey on Apr. 2, 1996 do hereby state that under requirements of P.A. 74, Michigan P.A. of 1970, the corner points mentioned in lines 1 and 2 above were in conformance with regulations and rules therefore as required in the current manual of survey instructions of the United States Department of the Interior, Bureau of Land Management or by a decree of a Court of Law and/or that the corner points mentioned in lines 3, 4 and 5 above were in conformance with the rules of the Michigan Board of Land Surveyors or by a Decree of a Court of Law, established, re-established, monumented, recovered, found as expressed below:

NOTE: Not more than 2 corners, all in the same town and range, may be recorded on this certificate.

A. Description of original monument and accessories and/or subsequent restoration:

H-1	1830	GLO	Mullett	Not Set
		Kent Co. Wit.		1/2" Iron
	1975	LCRC #847	Nederveld	Iron
	1984	LCRC #3705	Chettleburgh	Set Kent County Monument
	1991	LCRC #6049	Unema	Kent County Monument

P.A. 345 1900 KENT COUNTY

PEER APPROVED 5/30/96
CHAIRMAN Harry Hubert

The position of this corner was previously approved by the Kent County Remonumentation Peer Group, monumented by Thomas Chettleburgh on 1/25/84 and was recorded per LCRC #3705

B. Description of corner evidence found and/or method applied in restoring or reestablishing corner:

H-1 Found standard Kent Co. Mon. (Harrison) per witnesses from above LCRC as set by Thomas Chettleburgh on Twp. Line in place of the 5/8" Iron Pipe he found. Said Iron Pipe checks with Kent Co. Wit. and LCRC #847

LCRC #3705 (Nail/tag in trees)

LCRC #6049 (Nail/tag in trees)


20" Hickory N26°E 41.36'	20" Hickory N30°E 41.38'
39" W. Cherry S81°E 91.40'	20" W. Cherry S20°W 34.32'
17" W. Cherry S18°W 34.26'	12" Map. S75°W 16.47' 16" Oak N25°W 20.50'
23" Map. S71°W 39.68' 10" Map. S73°W 16.47'	26" Walnut S70°W 39.74'
S 1/4 cor. 34-6-10 East 56.76'	KC Mon. (S 1/4 34-6-10) East 56.76'

The selected location is accepted by me and is generally accepted by professional surveyors as the best available evidence of the position of the corner.

C. Description of monument for corner and accessories established to perpetuate locating the position of the corner:

H-1 Standard Kent County Monument

Nail & KC Remon. tag SE side	24" Hickory	N30°E	41.40'
New Nail & KC Remon. tag W. side	24" W. Cherry	S20°W	34.39'
New Nail & KC Remon. tag S. side	15" Maple	S75°W	16.47'
Nail & KC Remon. tag SE side	30" Walnut	S70°W	39.74'
Nail & KC Remon. tag SW side	16" Oak	N25°W	20.53'
Kent Co. Mon. (H-13, T6N, R10W)		East	56.76'
C/L grav. rd. S. is W. 10'±			
C/L grav. rd. N. is E. 29'±			

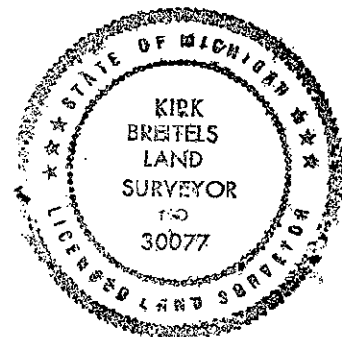

Signed by Kirk Breitels

Date 4/19/96

Surveyor's Michigan License No. 30077