

FEB 14 1997

COMMISSION

LAND CORNER RECORDATION CERTIFICATE
Filing Requirement of Act 74, Mich. P.A. 1970
KENT COUNTY REMONUMENTATION

For corners in


Kent (County)	Located in:	Caledonia Township	Corner Code #
1. Public Land Survey	T <u>5N</u>	R <u>10W</u>	<u>H-2</u>
	T _____	R _____	_____
	T _____	R _____	_____
	T _____	R _____	_____
2. Property Controlling in Section	S _____	T _____	R _____
	S _____	T _____	R _____
3. Miscellaneous Property in Sec.	S _____	T _____	R _____
	S _____	T _____	R _____

STATE OF MICHIGAN
COUNTY OF KENT
RECEIVED FOR RECORD
96 NOV -8 AM 9:22
REG. OF DEEDS
Lucy St. Paul
9511
Register of Deeds Stamp & File Number

4. Lot No. _____, Recorded Plat _____
5. Private Claims _____

I, Randy Kolehouse, in a field survey on March 29 19 96, do hereby certify that under requirements of P.A. 74 Michigan P.A. of 1970, the corner points mentioned in lines 1 and 2 above were in conformance with regulations and rules therefore as required in the current manual of survey instructions of the United States Department of the Interior, Bureau of Land Management or by a decree of a Court of Law and/or that the corner points mentioned in lines 3, 4 and 5 above were in conformance with the rules of the Michigan Board of Land Surveyors or by a Decree of a Court of Law; established, re-established, monumented, re-monumented, recovered, found as expressed below:

NOTE: Not more than 4 corners, all in the same town and range, may be recorded on this certificate.

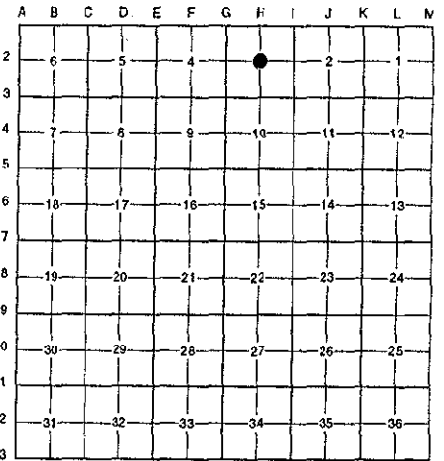

A. Description of original monument and accessories and/or subsequent restoration:

H-2 This corner was not originally set by the G.L.O.

1960	Witness Map	K.C. Surveyor	Iron
1975	L.C.R.C. #847	Medema, Van Kooten & Assoc.	Bt. Spike

B. Description of corner evidence found and/or method applied in restoring or reestablishing corner:

H-2 Found a 1/2" iron on the C/L of Alaska Avenue (gravel) running North and South on line of a fence row running East per L.C.R.C. # 847 and the Kent County Surveyor's records. Iron is 0.3' West and 1.1' South of the intersection of 1/4 lines. Accepted iron as Center of Section.

L.C.R.C. #847

- Nail in 30" Oak SE 38.81' (m. 39.36')
- Nail in 16" Oak E 67.00' (m. 74.12')
- Nail in 8" Triple Oak N-NE 49.66' (m. 49.60')
- SE corner house foundation #6385 N-NW 133.10'

P.A. 345 1990 KENT COUNTY
PEER APPROVED 8/22/96
CHAIRMAN *Harry Kabeer*

The selected location is accepted by me and is generally accepted by professional surveyors as the best available evidence of the position of the original corner:


C. Description of monument for corner and accessories established to perpetuate locating the position of the corner:

H-2 Replaced 1/2" Iron with a Standard Kent County Monument

- Nail & K.C. remon. tag on W side 38" Oak N 15° E 75.54'
- Nail & K.C. remon. tag on S side 30" Oak S 60° E 39.36'
- Nail & K.C. remon. tag on N side 20" Oak N 77° E 74.12'
- Nail & K.C. remon. tag on NW side 8" Tripple Oak N 40° E 49.60'
- SE corner house fndn. #6385 N 20° W 133.10

Signed by *Randy J. Kabeer*
EARTH TECH

Date 10/8/96

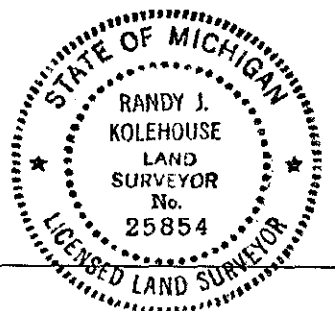

Surveyor's Michigan License No. 25854