

SURVEY & REMONUMENTATION

FEB 14 1997

COMMISSION

LAND CORNER RECORDATION CERTIFICATE
Filing Requirement of Act 74, Mich. P.A. 1970
KENT COUNTY REMONUMENTATION

For corners in

Kent (County)	Located in:	Caledonia Township	Corner Code #
1. Public Land Survey	T <u>5N</u>	R <u>10W</u>	<u>H-3</u>
	T _____	R _____	_____
	T _____	R _____	_____
	T _____	R _____	_____
2. Property Controlling in Section	S _____	T _____	R _____
	S _____	T _____	R _____
3. Miscellaneous Property in Sec.	S _____	T _____	R _____
	S _____	T _____	R _____

STATE OF MICHIGAN
 COUNTY OF KENT
 RECEIVED FOR RECORD

96 NOV -8 AM 9:22


REG. OF DEEDS

[Signature]

9512

Register of Deeds Stamp & File Number

4. Lot No. _____, Recorded Plat _____
5. Private Claims _____

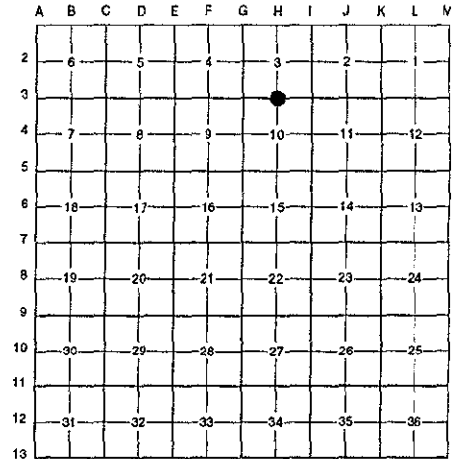

I, Randy Kolehouse, in a field survey on March 29 19 96, do hereby certify that under requirements of P.A. 74 Michigan P.A. of 1970, the corner points mentioned in lines 1 and 2 above were in conformance with regulations and rules therefore as required in the current manual of survey instructions of the United States Department of the interior, Bureau of Land Management or by a decree of a Court of Law and/or that the corner points mentioned in lines 3, 4 and 5 above were in conformance with the rules of the Michigan Board of Land Surveyors or by a Decree of a Court of Law; established, re-established, monumented, re-monumented, recovered, found as expressed below:

NOTE: Not more than 4 corners, all in the same town and range, may be recorded on this certificate.

A. Description of original monument and accessories and/or subsequent restoration:

H-3	1831	G.L.O. Notes	Mullett	Set Post
	1962	Witness Map	K.C. Surveyor	Iron
	1977	L.C.R.C. #1025	Exxel Engineering	1/2" Iron
	1982	L.C.R.C. #2694	Jonker Land Surveys	Fnd. 1/2" Iron / Set K.C. Monument in Pavement
	1995	L.C.R.C. #8105	K. Breitels	K.C. Monument

This corner was originally approved by the Kent County Remonumentation Peer Group and monumented by Rob Jonker on 3/16/82 and was recorded per L.C.R.C. #2694.

B. Description of corner evidence found and/or method applied in restoring or reestablishing corner:

H-3 Found a Standard Kent County Monument in a broken monument box 2' ± East of the C/L of Thornapple River Drive (bit.) running North and South and 135' South of the C/L intersection of Orlee and Thornapple River Drive per L.C.R.C.'s #2694 and #8105 as set by Rob Jonker in place of a 1/2" iron he found which checked L.C.R.C. #1025 and the K.C. Surveyor's records. Set two P.K. nails 1' off-center of broken monument.

L.C.R.C. #2694

SE corner fnd. to house #6787 N 60° W 73.69'
 NE corner fnd. to house #6807 S 70° W 68.32'
 Remon. tag on N side tw 8" Hackberry S 65° E 43.59'
 Face steel fe. cor. post S 35° E 37.42'

L.C.R.C. #8105

SE corner fnd. to house #6787 N 60° W 73.69'
 NE corner fnd. to house #6807 S 70° W 68.32'
 Nail & KC Remon. tag N. side Tw. 14" Hackberry S 65° E 43.62' (m. 43.65')
 Face steel fence cor. post S 35° E 37.45' (m. 37.42')

The selected location is accepted by me and is generally accepted by professional surveyors as the best available evidence of the position of the original corner.

C. Description of monument for corner and accessories established to perpetuate locating the position of the corner:

H-3 Reset Standard Kent County Monument

SE corner fndn. to hse. #6787 N 60° W 73.69'
 NE cor. fndn. to hse. #6807 S 70° W 68.32'
 Nail & K.C. remon. tag on N side 8" Twin Hackberry S 65° E 43.65'
 Face steel fence cor. post S 35° E 37.42'
 Nail & K.C. remon. tag on in SW side 18" Maple S 30° E 47.15'

P.A. 345 1990 KENT COUNTY

PEER APPROVED 7/25/96

CHAIRMAN *[Signature]*

Signed by *[Signature]*
 EARTH TECH

Date 10/8/96

Surveyor's Michigan License No. 25854

