

**SURVEY & REMONUMENTATION**

FEB 14 1997

COMMISSION

**LAND CORNER RECORDATION CERTIFICATE**  
**Filing Requirement of Act 74, Mich. P.A. 1970**  
**KENT COUNTY REMONUMENTATION**

For corners in

Kent (County)	Located in: Caledonia Township	Corner Code #
1. Public Land Survey	T <u>5N</u> R <u>10W</u>	<u>H-4</u>
	T _____ R _____	_____
	T _____ R _____	_____
	T _____ R _____	_____
2. Property Controlling in Section	S _____ T _____ R _____	_____
	S _____ T _____ R _____	_____
3. Miscellaneous Property in Sec.	S _____ T _____ R _____	_____
	S _____ T _____ R _____	_____

REG. OF DEEDS

*Handwritten signature*

96 DEC 27 AM 10:49

STATE OF MICHIGAN  
 COUNTY OF KENT  
 RECEIVED FOR RECORD

9615

Register of Deeds Stamp & File Number

4. Lot No. \_\_\_\_\_, Recorded Plat \_\_\_\_\_  
 5. Private Claims \_\_\_\_\_

I, Randy Kolehouse, in a field survey on April 9 19 96, do hereby certify that under requirements of P.A. 74 Michigan P.A. of 1970, the corner points mentioned in lines 1 and 2 above were in conformance with regulations and rules therefore as required in the current manual of survey instructions of the United States Department of the Interior, Bureau of Land Management or by a decree of a Court of Law and/or that the corner points mentioned in lines 3, 4 and 5 above were in conformance with the rules of the Michigan Board of Land Surveyors or by a Decree of a Court of Law; established, re-established, monumented, re-monumented, recovered, found as expressed below:

	A	B	C	D	E	F	G	H	I	J	K	L	M
2	6	5	4	3	2	1							
3													
4	7	8	9	10	11	12							
5													
6	18	17	16	15	14	13							
7													
8	19	20	21	22	23	24							
9													
10	30	29	28	27	26	25							
11													
12	31	32	33	34	35	36							
13													

NOTE: Not more than 4 corners, all in the same town and range, may be recorded on this certificate.

A. Description of original monument and accessories and/or subsequent restoration:

H-4 This corner was not originally set by the G.L.O.

1977	L.C.R.C. #1625	Exxel Engineering	Set Iron @ Intersection of 1/4 Lines
1992	L.C.R.C. #6569	T. Chettleburgh	Fnd. Iron / Set K.C. Monument
1995	L.C.R.C. #8106	K. Breitels	K.C. Monument

345 1990 KENT COUNTY  
 PEER APPROVED 8/22/96

CHAIRMAN T. Chettleburgh

This corner was originally approved by the Kent County Remonumentation Peer Group and monumented by T. Chettleburgh on 5/27/92 and was recorded per L.C.R.C. #6569.

B. Description of corner evidence found and/or method applied in restoring or reestablishing corner:

H-4 Found a Standard Kent County Monument per L.C.R.C.'s #6569 and #8106 as set by T. Chettleburgh in place of a 3/4" iron he found which was set by Exxel Engineering at the intersection of 1/4 lines Monument is 0.04' East and 0.08' South of intersection of 1/4 lines.

L.C.R.C. #6569

- Remon tag in NW side 54" Oak N 25° E 76.67'
- Remon tag in SW side 37" Oak S 45° E 42.94'
- Remon tag in SW side 32" Maple S 20° E 87.42'
- Remon tag in SE side 6" Maple S 32° W 56.10'

L.C.R.C. #8106


- Nail & KC Remon. tag NW side 54" Oak N 25° E 75.72'
- Nail & KC Remon. tag SW side 37" Oak S 45° E 42.98'
- Nail & KC Remon. tag SW side 32" Oak S 20° E 87.48'
- Nail & KC Remon. tag SE side 10" Maple S 32° W 56.12'
- Capped Iron S 90° E 33.00'
- Tree row to East is 15' m/l N.; Tree row & fence to West is 8' m/l S.

The selected location is accepted by me and is generally accepted by professional surveyors as the best available evidence of the position of the original corner.

C. Description of monument for corner and accessories established to perpetuate locating the position of the corner:

H-4 Standard Kent County Monument

- Nail & K.C. remon. tag on NW side 54" Oak N 25° E 75.72'
- Nail & K.C. remon. tag on SW side 37" Oak S 45° E 42.98'
- Nail & K.C. remon. tag on SW side 32" Oak S 20° E 87.48'
- Nail & K.C. remon. tag on SE side 10" Maple S 32° W 56.12'
- Capped iron on S 90° E 33.00'
- Tree row to East is 15' m/l North; Tree row & fence to West is 8' m/l South

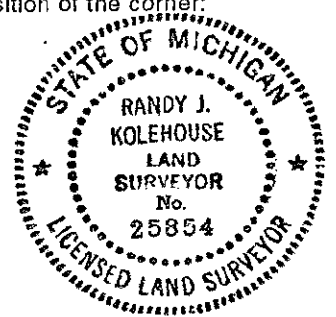

Signed by Randy J. Kolehouse  
 EARTH TECH

Date 12/29/96

Surveyor's Michigan License No. 25854