

\$7.00 SURVEY &  
\$2.00 REMONUMENTATION

LAND CORNER RECORDATION CERTIFICATE  
Filing Requirement of Act 74, Mich. P.A. 1970  
KENT COUNTY REMONUMENTATION

For corners in FEB 14 1997


Kent (County) COMMISSION located in: Caledonia Township Corner Code #

1. Public Land Survey	T <u>5N</u>	R <u>10W</u>	<u>H-5</u>
	T _____	R _____	_____
	T _____	R _____	_____
	T _____	R _____	_____
2. Property Controlling in Section	S _____	T _____	R _____
	S _____	T _____	R _____
3. Miscellaneous Property in Sec.	S _____	T _____	R _____
	S _____	T _____	R _____

STATE OF MICHIGAN  
COUNTY OF KENT  
RECEIVED FOR RECORD  
96 NOV -8 AM 9:22  
REG. OF DEEDS  
*[Signature]*  
9513

Register of Deeds Stamp & File Number

4. Lot No. \_\_\_\_\_, Recorded Plat \_\_\_\_\_  
5. Private Claims \_\_\_\_\_

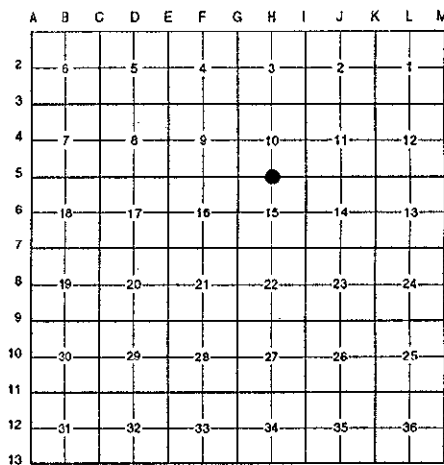

I, Randy Kolehouse, in a field survey on March 26 19 96, do hereby certify that under requirements of P.A. 74 Michigan P.A. of 1970, the corner points mentioned in lines 1 and 2 above were in conformance with regulations and rules therefore as required in the current manual of survey instructions of the United States Department of the interior, Bureau of Land Management or by a decree of a Court of Law and/or that the corner points mentioned in lines 3, 4 and 5 above were in conformance with the rules of the Michigan Board of Land Surveyors or by a Decree of a Court of Law; established, re-established, monumented, re-monumented, recovered, found as expressed below:

NOTE: Not more than 4 corners, all in the same town and range, may be recorded on this certificate.

A. Description of original monument and accessories and/or subsequent restoration:

H-5	1831	G.L.O. Notes	Mullett	Set Post	P.A. 345 1990 KENT COUNTY
	1974	Witness Map	K.C. Surveyor	"T" Iron	PEER APPROVED <u>7/25/96</u>
	1976	L.C.R.C. #955	McPherson	"T" Iron	CHAIRMAN <i>[Signature]</i>
	1981	L.C.R.C. #2062	Nederveld & Jonker	Fnd. "T" Iron / Set K.C. Monument	
	1995	L.C.R.C. #8107	K. Breitels	K.C. Monument	

This corner was originally approved by the Kent County Remonumentation Peer Group and monumented by Nederveld & Jonker on 7/7/81 and was recorded per L.C.R.C. #2062.

B. Description of corner evidence found and/or method applied in restoring or reestablishing corner:

H-5 Found a Standard Kent County Monument 1' East of the C/L of Alaska Avenue (gravel) running North and South on line of fence line running East and West per L.C.R.C.'s #2062 and #8107 as set by Nederveld & Jonker in place of a "T" Iron they found which checked L.C.R.C. #955 and the K.C. Surveyor's records.

L.C.R.C. #2062

L.C.R.C. #8107

NE cor. conc. post @ ground N 86° W 33.0'  
Nail & K.C. Remon. tag NE side 28" Maple N 55° W 37.95'  
Nail & K.C. Remon. tag SE side 30" Maple S 28° W 66.54'  
Nail & K.C. Remon. tag S side 36" Oak N 90° E 32.23'  
Centerline Gravel Road 1' West

NE cor. conc. post at ground N 86° W 33.00'  
Nail & KC Remon. tag NE side 40" Maple N 55° W 38.00' (m. 38.01')  
Nail & KC Remon. tag SE side 40" mAPLE s 28° w 66.65' (m. 66.60')  
Nail & KC Remon. tag S. side 48" Oak N 90° E 32.29' (m. 32.13')  
Nail & KC Remon. tag NE side 32" Oak S 40° E 26.77' (m. 26.73')

The selected location is accepted by me and is generally accepted by professional surveyors as the best available evidence of the position of the original corner.

C. Description of monument for corner and accessories established to perpetuate locating the position of the corner:

H-5 Standard Kent County Monument

NE cor. conc. post at ground N 86° W 33.0'  
Nail & K.C. remon. tag on NE side 28" Maple N 55° W 38.01'  
Nail & K.C. remon. tag on SE side 30" Maple S 28° W 66.60'  
Nail & K.C. remon. tag on S side 36" Oak N 90° E 32.13'  
Nail & K.C. remon. tag on NE side 20" Oak S 40° E 26.73'

Signed by *[Signature]*  
EARTH TECH

Date 12/8/96

Surveyor's Michigan License No. 25854

